





Soffit panel Detail 'A' (scale 1:10) 1 No. req'd as shown

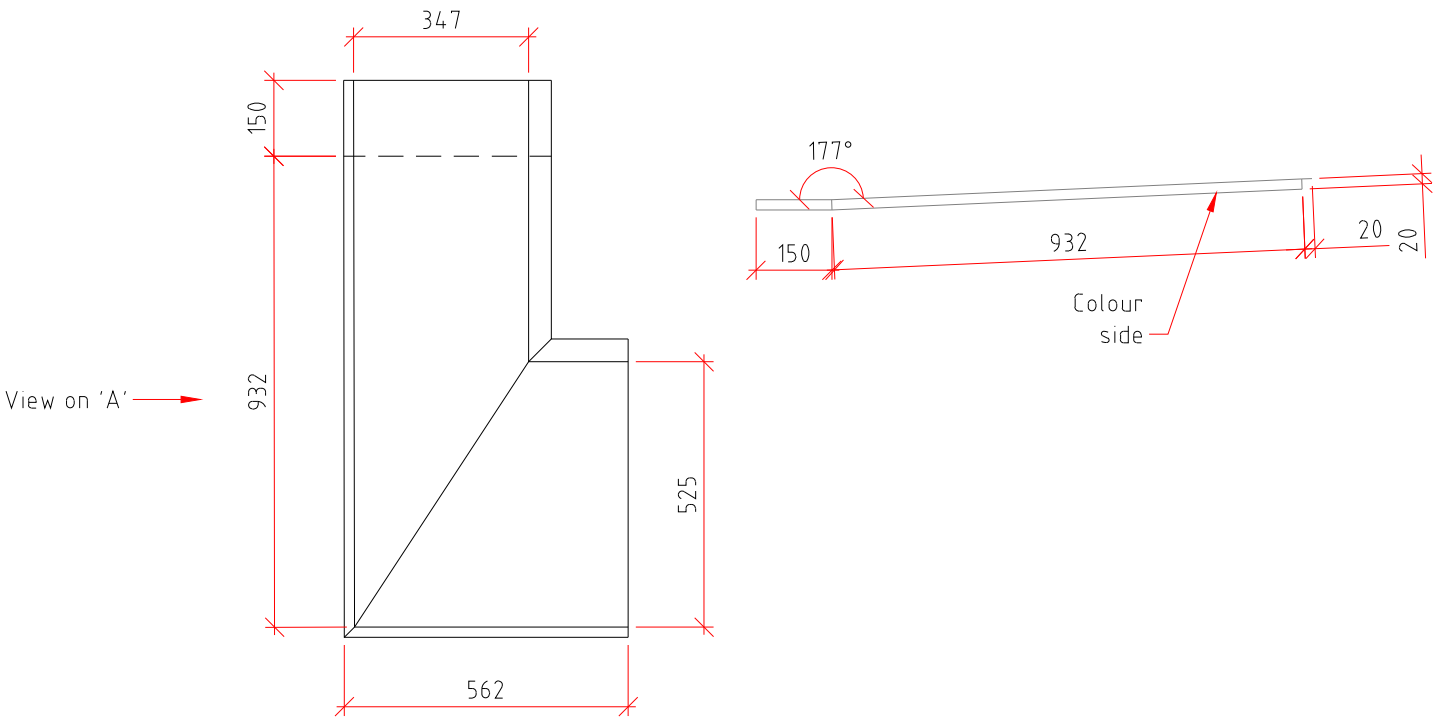


Soffit panel Detail 'B' (scale 1:15) 1 No. req'd as shown

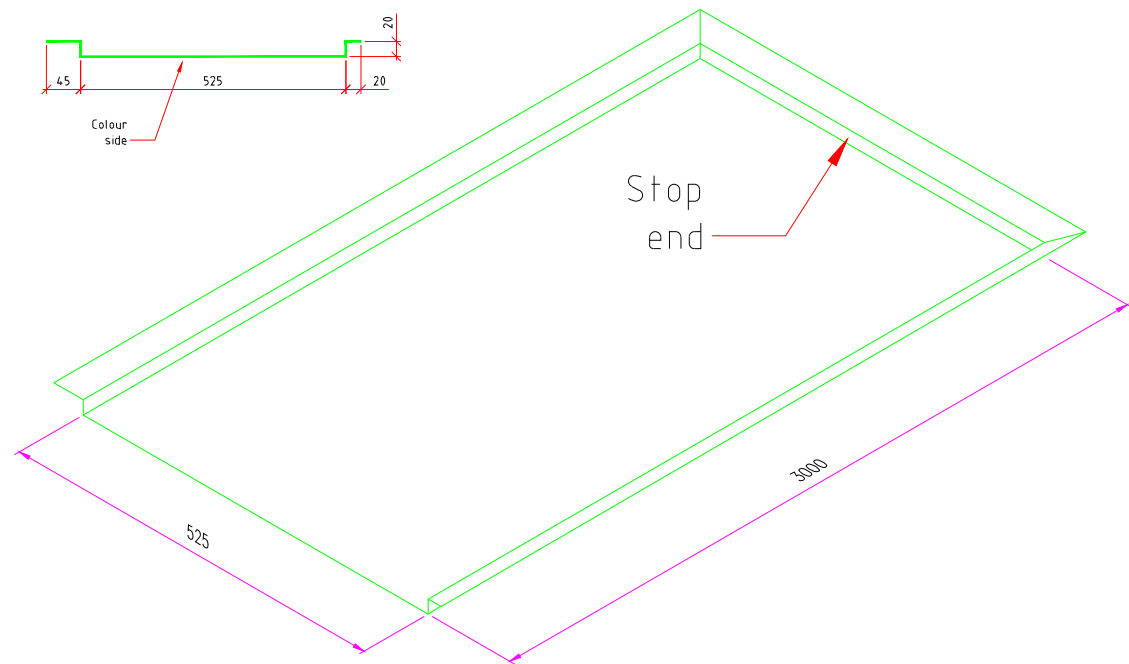

Soffit panel Detail 'C' (scale 1:10) 1 No. req'd as shown

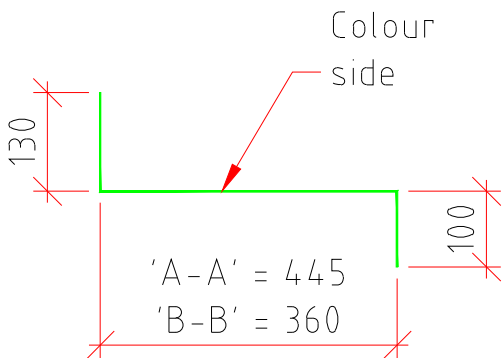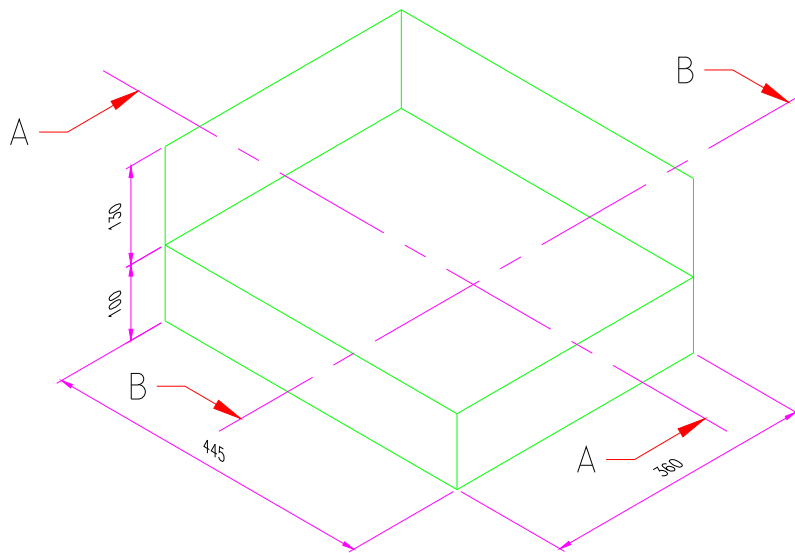

Soffit panel Detail 'D' (scale 1:10) 1 No. req'd as shown

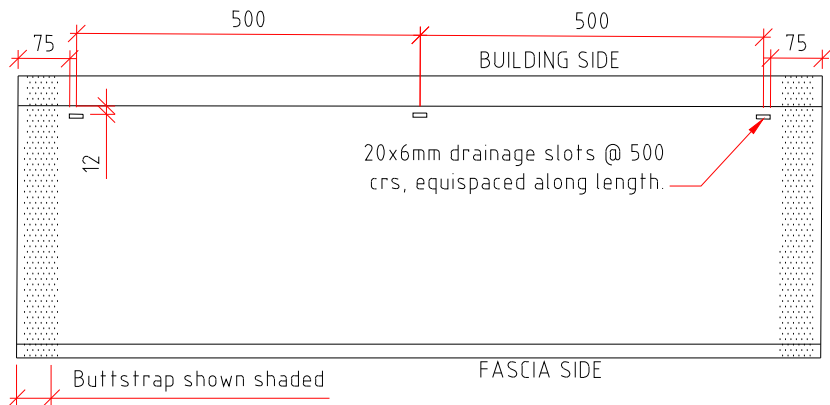

Drainage slot details

MATERIAL – 3mm Aluminium  
PPC to RAL 9006  
fully welded, dressed prior to PPC.

AS BUILT 19/11/21

C01	CONSTRUCTION ISSUE	RM	29/10/21
P03	DRAINAGE SLOT DETAIL ADDED	RM	06/07/21
P02	GENERAL REWORKING	RM	22/06/21
P01	FIRST ISSUE	RM	04/06/21
Rev	Description	By	Date
<div>  <div> 19A Wilson Street, Hamilton, ML3 0NH   +44 (0) 1698 339 104 ajcladding.co.uk info@ajcladding.co.uk </div> </div>			
Drawn By	RM	Date Created	20/04/21
Contract No.	2020	Scale	1:50
Contract Title	20: 20 HOUSE	ot	A3
Drawing Title	FIRE STRATEGY – SOFFIT DETAILS		
Drawing No.	2020-PH01-FS-020	Rev	C01