




ELE - PH02-SOUTH-01

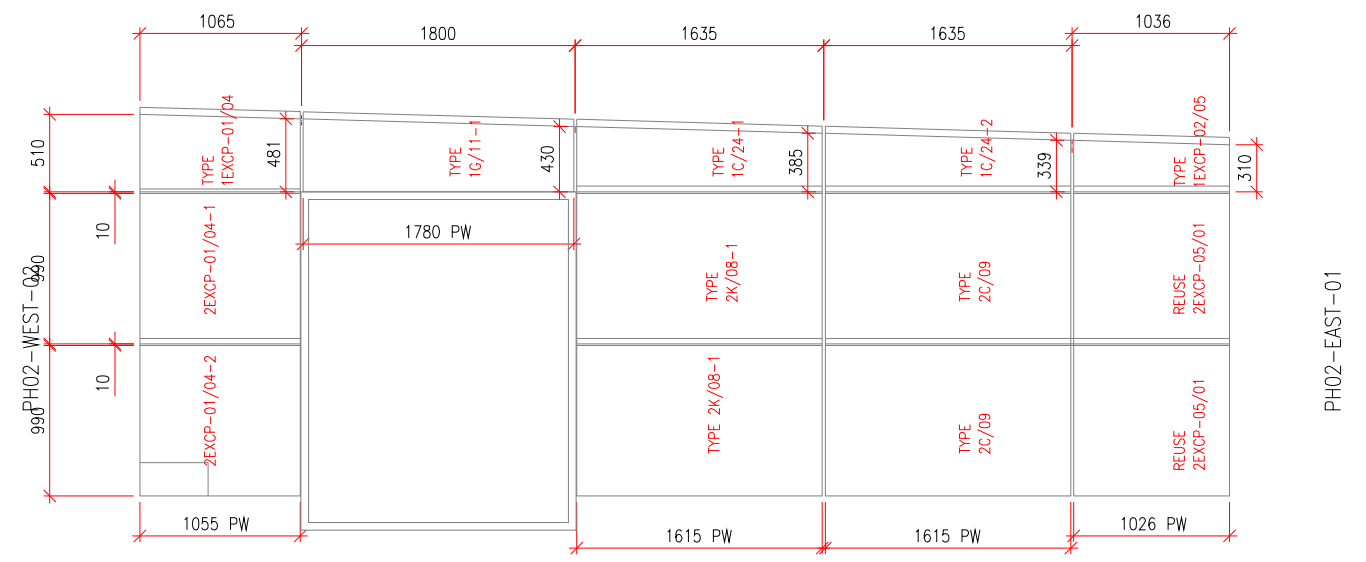


ELE - PH02-SOUTH-02

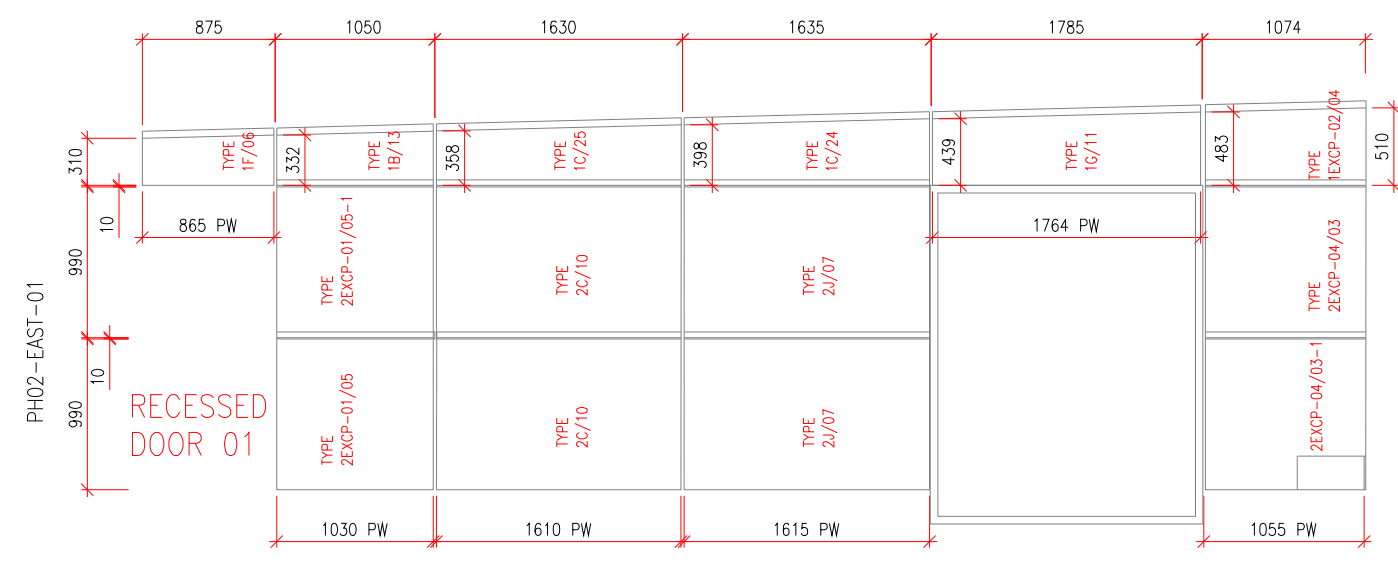

ELE - PH02-SOUTH-03

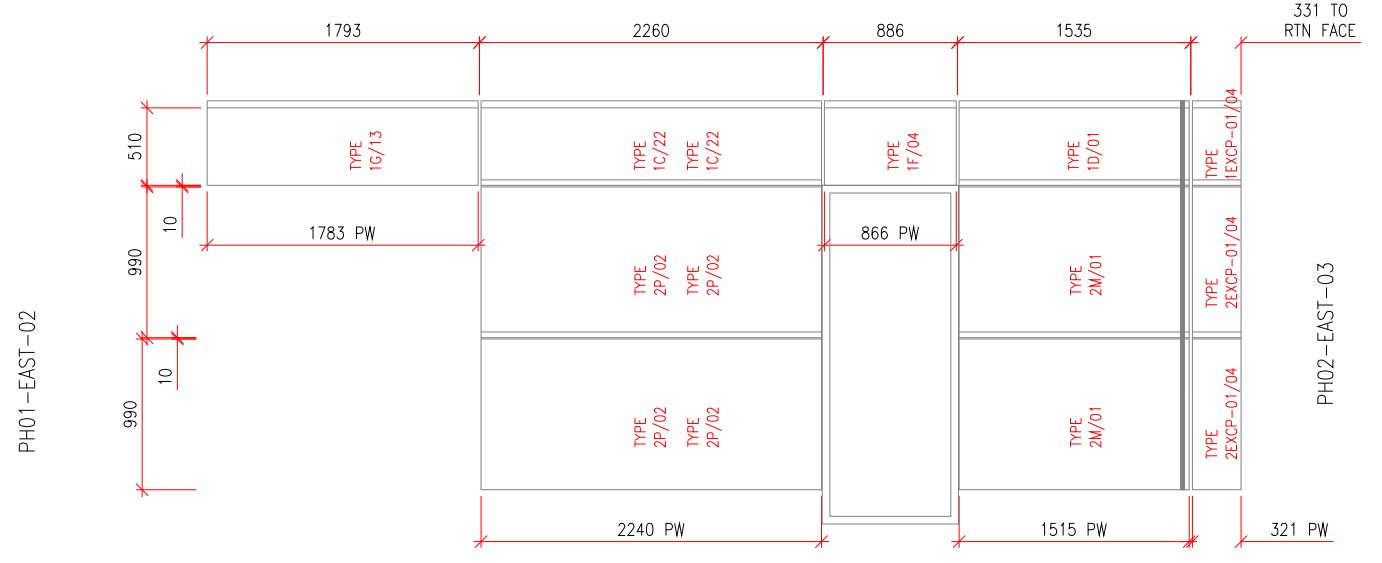


ELE - PH02-SOUTH-04

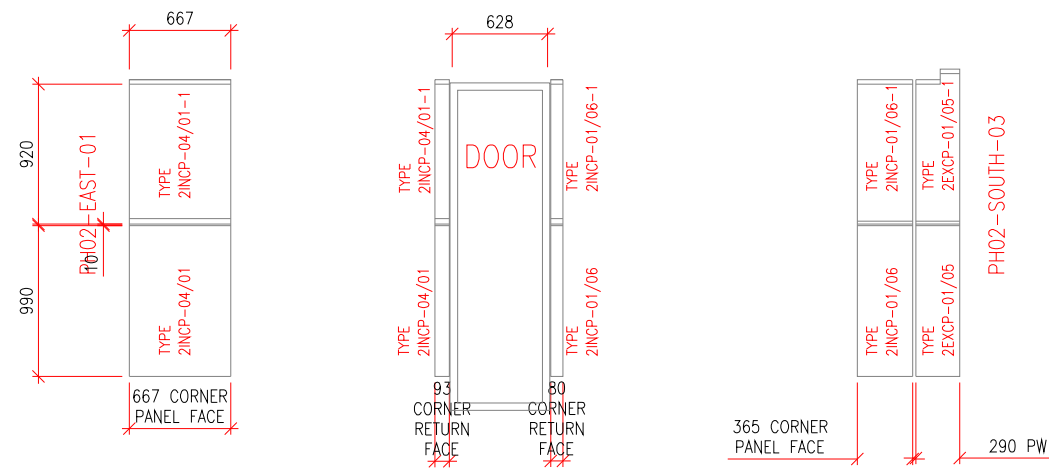

PH02 RECESSED DOOR 01

AS BUILT 19/11/21

C01	CONSTRUCTION ISSUE	RM	28/10/21
P04	PANEL HEIGHTS REVISED	RM	09/09/21
P03	GENERAL UPDATES.	RM	03/09/21
P02	PANEL REFS ADDED	RM	22/07/21
P01	FIRST ISSUE	RM	05/07/21
Rev	Description	By	Date
<div><div><div><div>AJ Cladding LTD</div><div>Architectural Cladding Specialists</div></div><div><div>19A Wilson Street, Hamilton, ML3 0NH</div><div>+44 (0) 1698 339 104 ajcladding.co.uk info@ajcladding.co.uk</div></div></div></div>			
Drawn By	RM	Date Created	04/01/21
Contract No.	2020	Scale	1:50
Contract Title	20:20 HOUSE	ot	A3
Drawing Title	PENTHOUSE 02 SOUTH ELEVATION CLADDING SETOUTS 03		
Drawing No.	2020-PH02-ELE-003	Rev	C01