




ELE - PH01-WEST-01

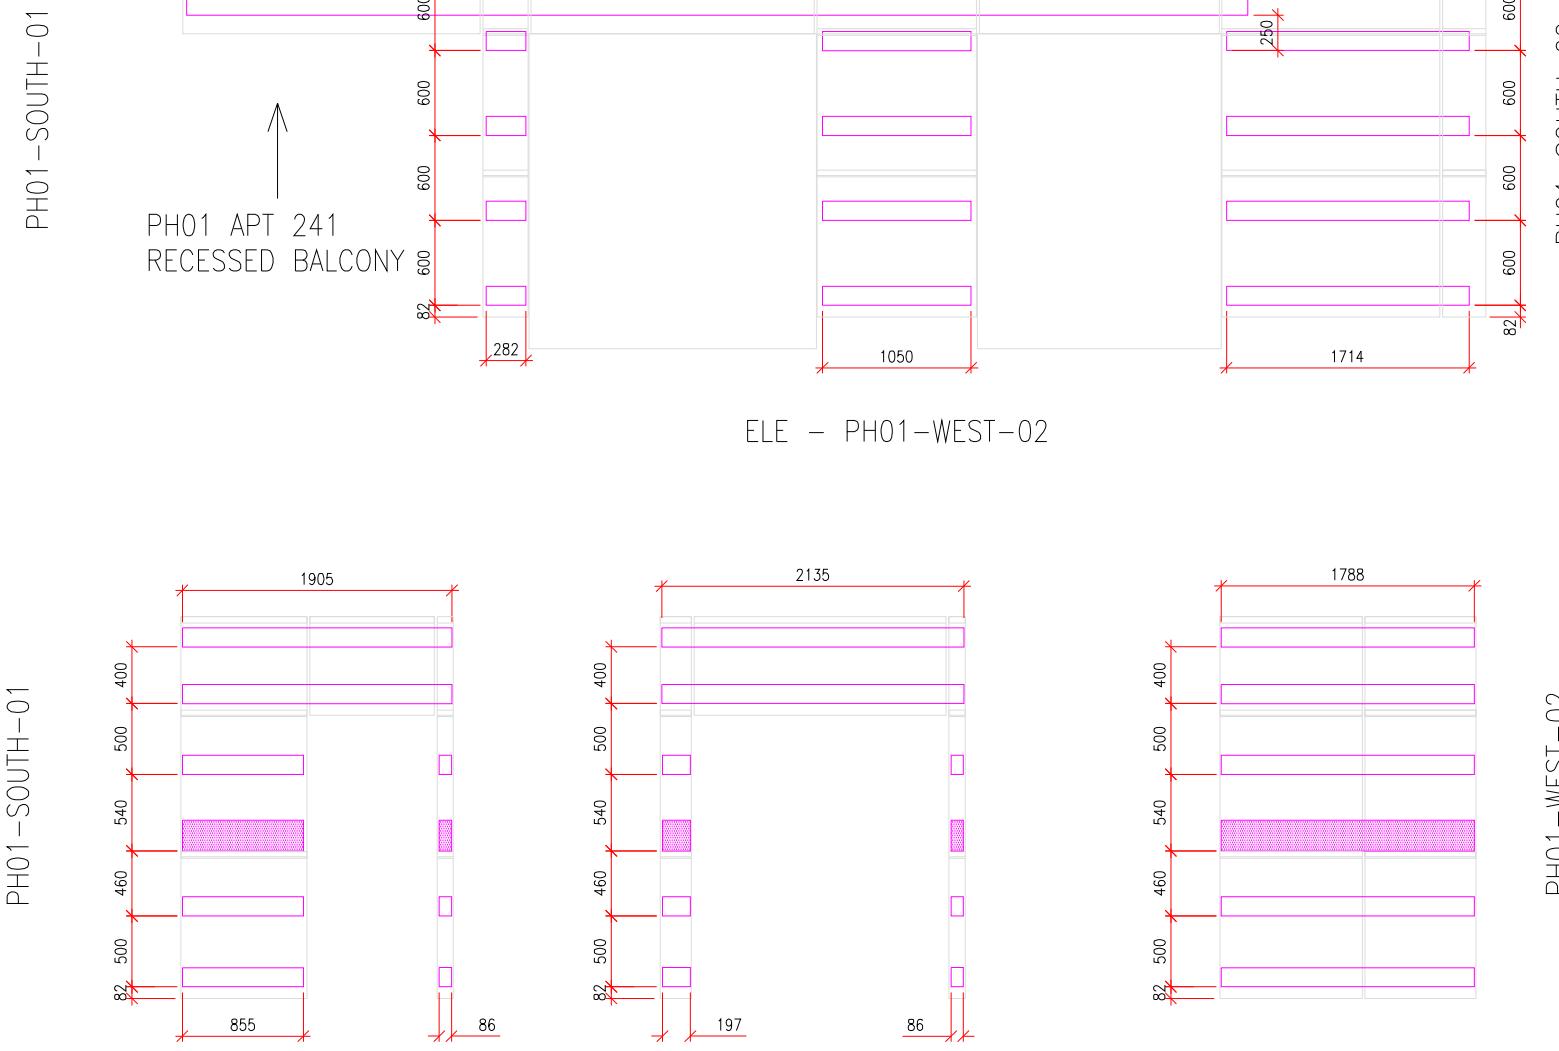


PH01 APT 241
RECEIVED BALCONY

PHO1 WEST 02

AS BUILT 19/11/21

DESIGNED AND INSTALLED AS PER FASTFRAME DESIGN CALCULATIONS. PLEASE REFER TO FILES; –
'FASTFRAME CALCULATIONS V7 [AB-19-03-21].PDF'
'2020 BUILDING V2 – 202191020 [AB-19-03-21].PDF'
'GENIUS-PRIME-R18122 PRIME TEST DATA (3).PDF'

NOTES

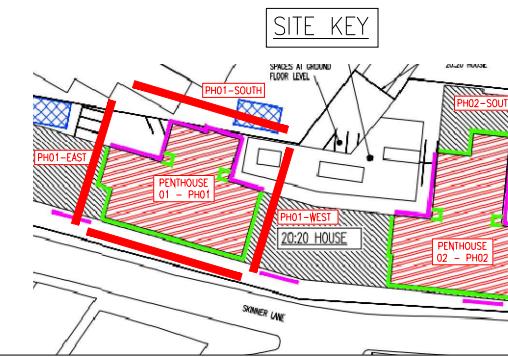

SUPPORT TRAY 02 (T02) - 135 TRAY

SUPPORT TRAY 01 (T01) - 210 TRAY

C02	UPDATED AS PER WINTECH EMAIL 18/11/21	RM	18/11/21
C01	CONSTRUCTION ISSUE	RM	29.10.21
P05	UPDATED AS PER WINTECH COMMENTS	RM	01.10.21
P04	TRAY CTRS AMMENDED TO V2 CALCS IN RECESSED BALCONIES	RM	24.09.21
P03	TRAY CTRS AMMENDED TO V2 CALCS IN RECESSED BALCONIES	SA	06.05.21
P02	TRAY CTRS AMMENDED TO V7 CALCS	SA	09.03.21
Rev	Description	By	Date

19A Wilson Street,
Hamilton,
ML3 0NH
+44 (0) 1698 339 1
ajcladding.co.uk
info@ajcladding.co.uk

AJ Cladding LTD Architectural Cladding Specialists				+44 (0) 1698 339 104 ajcladding.co.uk info@ajcladding.co.uk		
Drawn By	SA	Date Created	04.01.20	Scale	NTS	at
Contract No.	2020					
Contract Title	20:20 HOUSE					
Drawing Title	PENTHOUSE 01 WEST ELEVATION SUPPORT TRAY SETOUTS 01					
Drawing No.	2020-PH01-WES-BKT-002				Rev	C02