




ELE - PH02-SOUTH-01

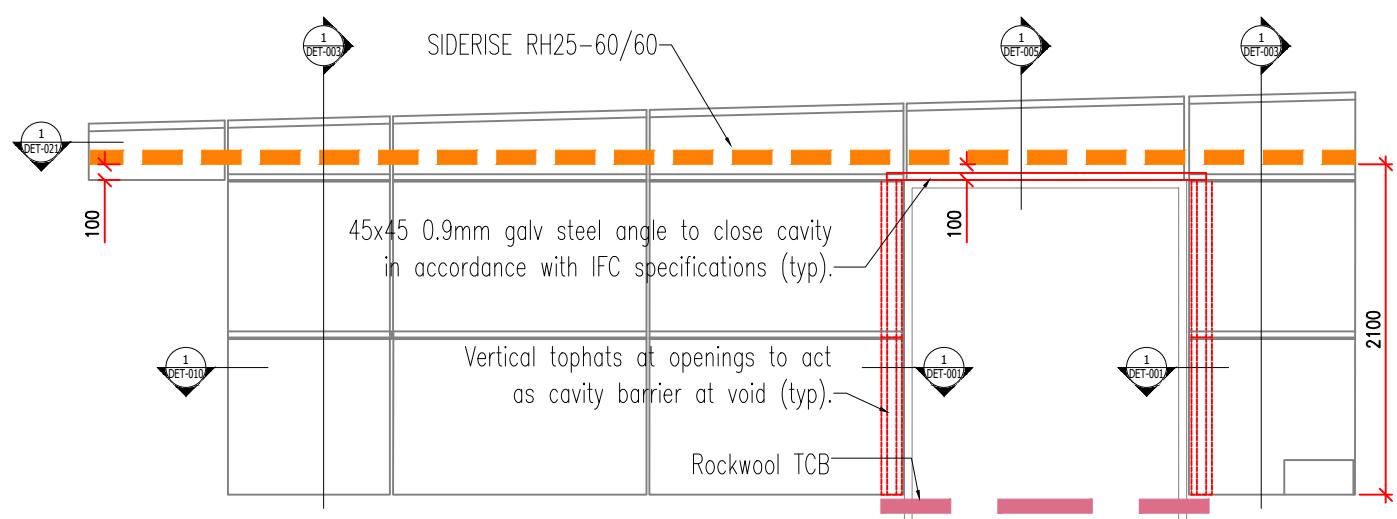

ELE - PH02-SOUTH-02

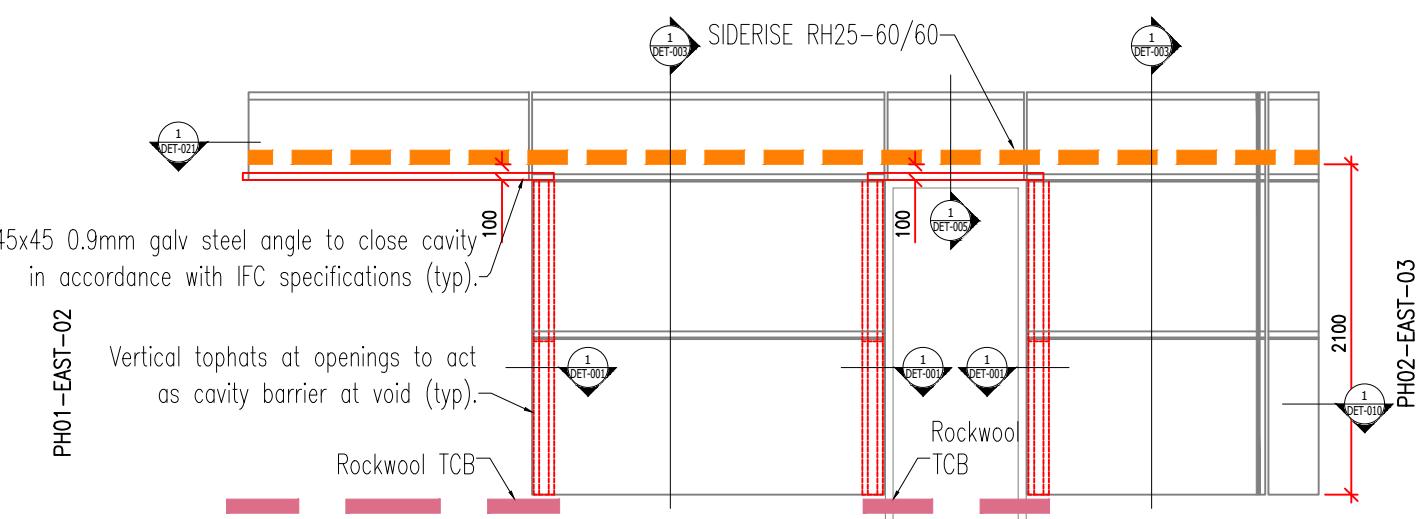

ELE - PH02-SOUTH-03

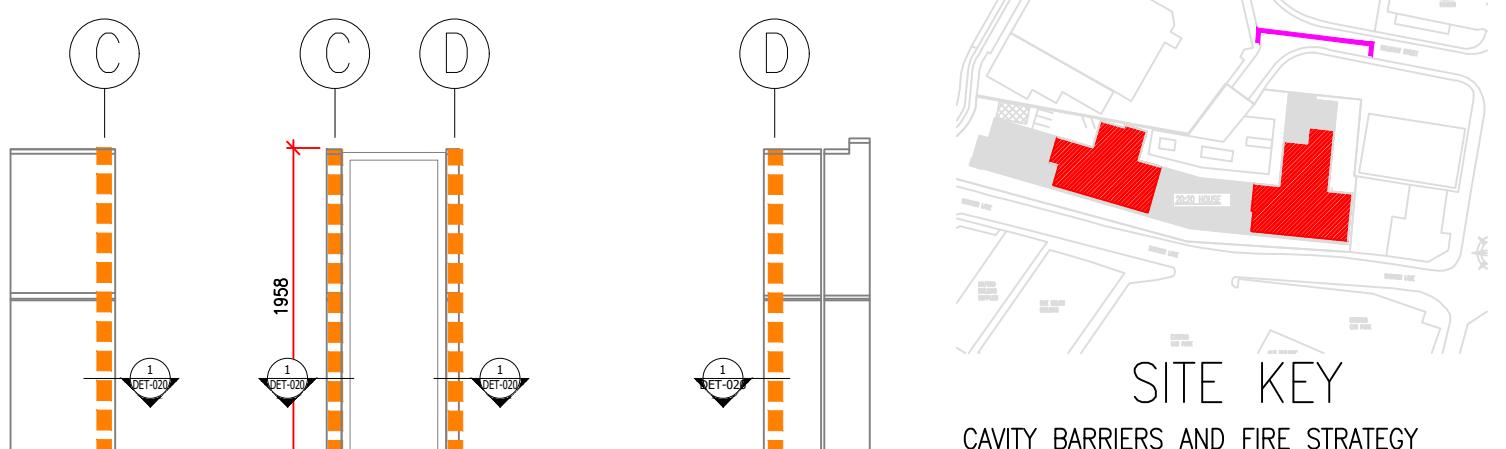

ELE - PH02-SOUTH-04

AS BUILT 19/11/21

Denoted Siderise RH25-60/60 horizontal cavity barriers run continuously round building, typically 100mm above window openings.

Denoted Siderise RV-90/60 cavity barrier with OSCI inserts to cladding panel depth.

Denotes Rockwool TCB cavity barrier. To be installed from inside flats by others at every window and door. Barriers to extend 150mm past openings.



Denoted Siderise non vented cavity barrier round wall vent ducting.

C01	IFC NOTE ADDED - CONSTRUCTION ISSUE	RM	28/10/21
-----	-------------------------------------	----	----------

P06	UPDATED AS PER WINTECH COMMENTS 08/10/21	RM	14/10/21
-----	--	----	----------

P05	UPDATED AS PER WINTECH COMMENTS 30/09/21	RM	01/10/21
-----	--	----	----------

P04	UPDATED AS PER WINTECH COMMENTS 16/09/21	RM	23/09/21
-----	--	----	----------

P03	DETAIL REFS ADDED	RM	14/9/21
-----	-------------------	----	---------

P02	GENERAL UPDATES.	RM	17/06/21
-----	------------------	----	----------

P01	FIRST ISSUE	RM	18/05/21
-----	-------------	----	----------

Rev	Description	By	Date
-----	-------------	----	------

19A Wilson Street,  
Hamilton,  
ML3 0NH

+44 (0) 1698 339 104  
ajcladding.co.uk  
info@ajcladding.co.uk

Drawn By	RM	Date Created	18/05/21	Scale	1:50	at A3
Contract No.	2020					
Contract Title	20: 20 HOUSE					
Drawing Title	PENTHOUSE 02 SOUTH ELEVATION CAVITY BARRIER LAYOUT					
Drawing No.	2020-PH02-FS-005	Rev	C01			