

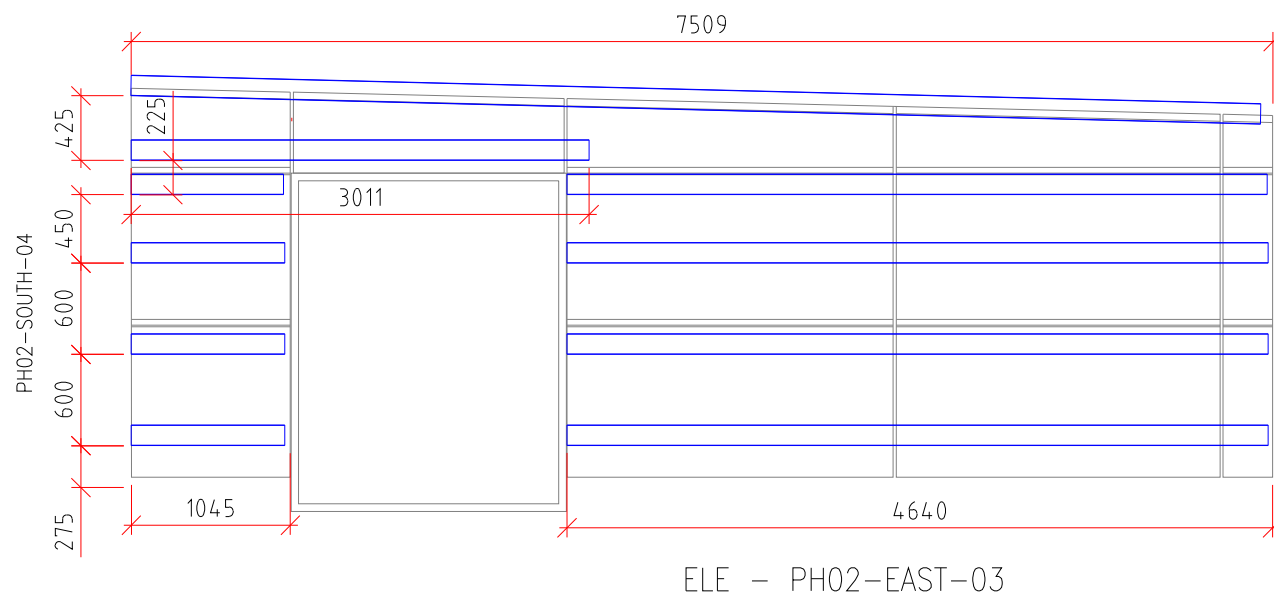


AS BUILT 19/11/21

DESIGNED AND INSTALLED AS PER FASTFRAME DESIGN CALCULATIONS. PLEASE REFER TO FILES; -
'2020 HOUSE - PENTHOUSE NO. 2 - STEEL - VERTICAL FACADE - 90MM - GENIUS PRIME - 202041021_V1.PDF'
'2020 BUILDING - RECESS BALCONIES - STEEL - VERTICAL FACADE - 90MM - GENIUS PRIME - 202041021_V1.PDF'


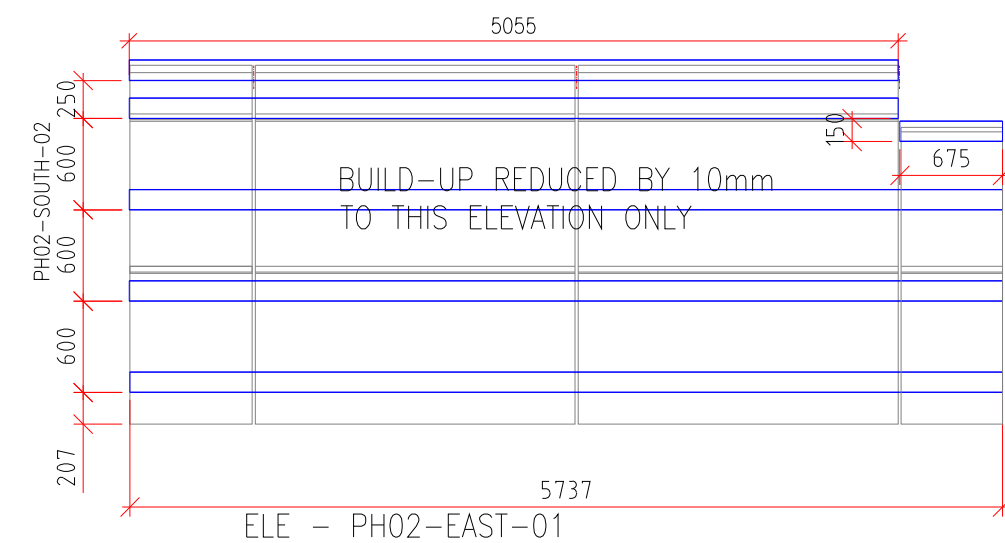


PH02-NORTH-01

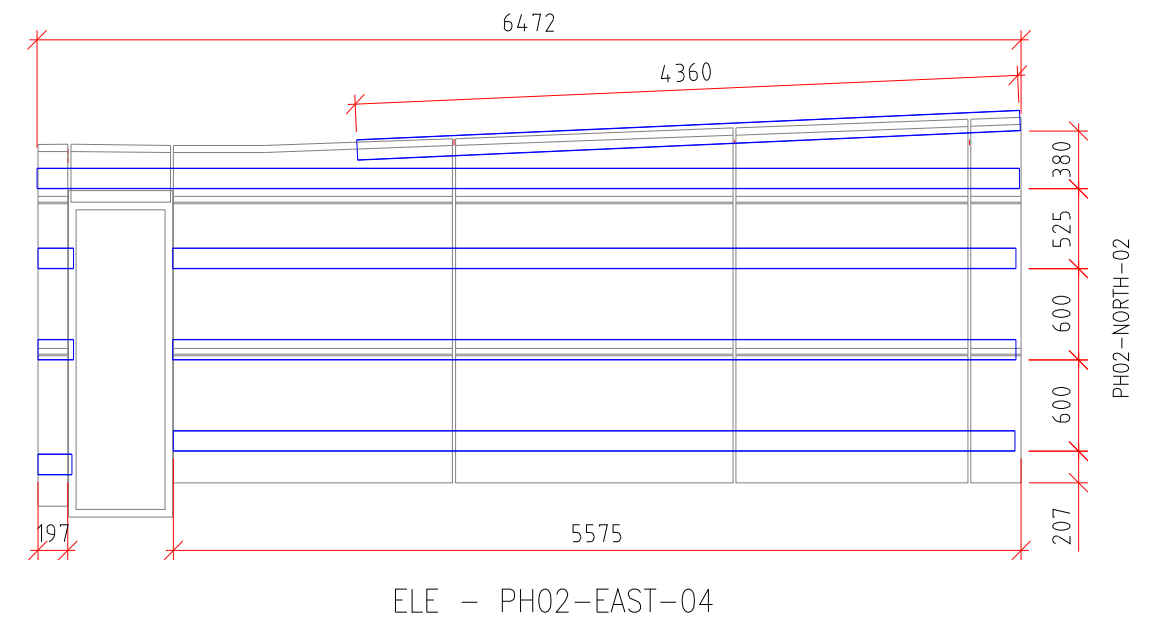


PH02-SOUTH-03

PH02-EAST-02

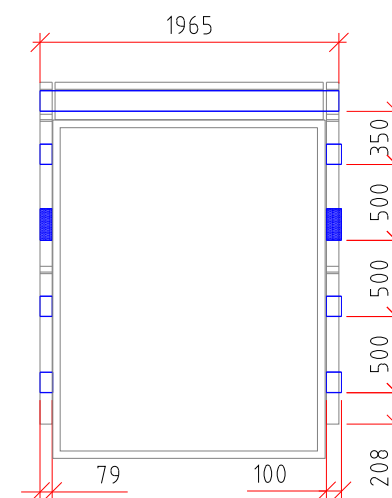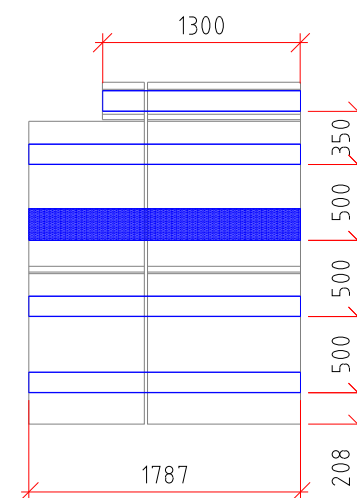


PH02 APT 124
RECESSED BALCONY

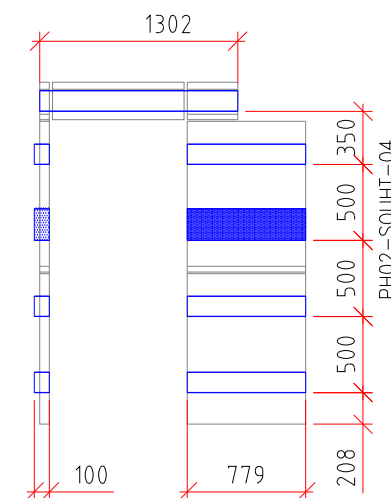

PH02-SOUTH-04

- 135x30 2mm GALV CHANNEL
- 200x30 2mm GALV CHANNEL

C01	CONSTRUCTION ISSUE	RM	28/10/21
P05	UPDATED AS PER WINTech COMMENTS 08/10/21	RM	15/10/21
P04	UPDATED AS PER WINTech COMMENTS 30/09/21	RM	01/10/21
P03	UPDATED AS PER WINTech COMMENTS 16/09/21	RM	23/09/21
P02	SET-OUT HEIGHTS REVISED.	RM	26/08/21
P01	FIRST ISSUE	SA	09/07/21
Rev	Description	By	Date
<div><div>19A Wilson Street, Hamilton, ML3 0NH</div><div>AJ Cladding LTD Architectural Cladding Specialists</div></div> <div>+44 (0) 1698 339 104 ajcladding.co.uk info@ajcladding.co.uk</div>			
Drawn By	SA	Date Created	9/07/21
Contract No.	2020	Scale	1:50
Contract Title	20: 20 HOUSE	ot	A3
Drawing Title	PENTHOUSE 02 EAST ELEVATION GALV CHANNEL SETOUT 04		
Drawing No.	2020-PH02-CH-004	Rev	C01