



PH01 – WEST – 01

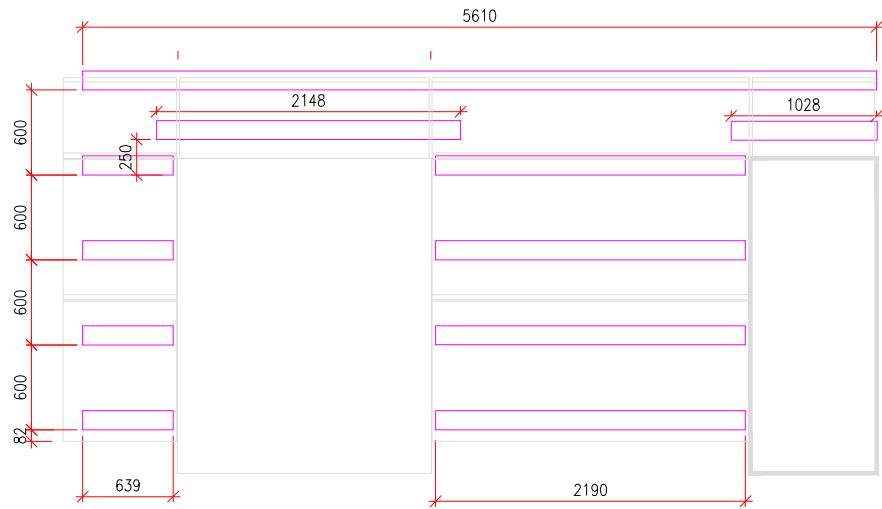

ELE – PH01 – SOUTH – 01


PH01 – WEST – 02

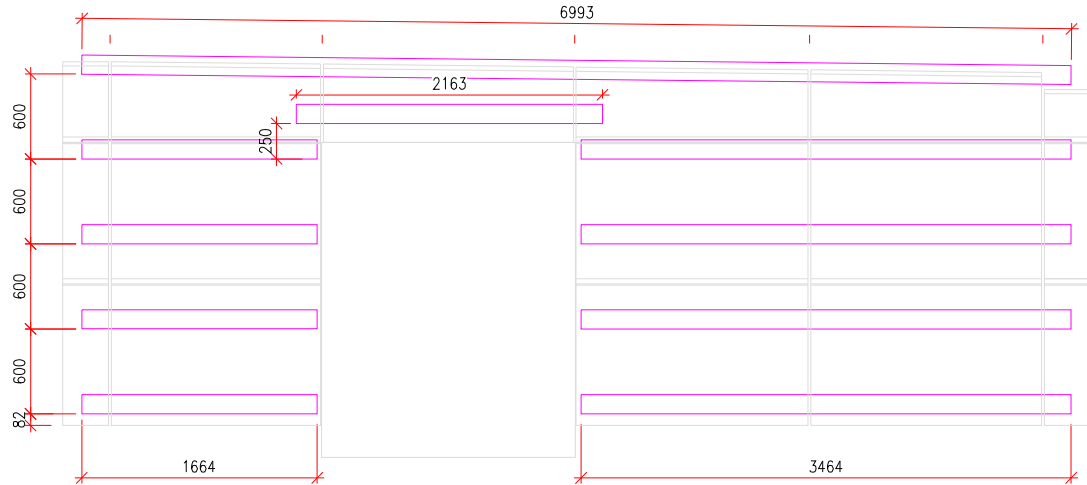

ELE – PH01 – SOUTH – 02

PH01 – EAST – 01


PH01 – EAST – 01

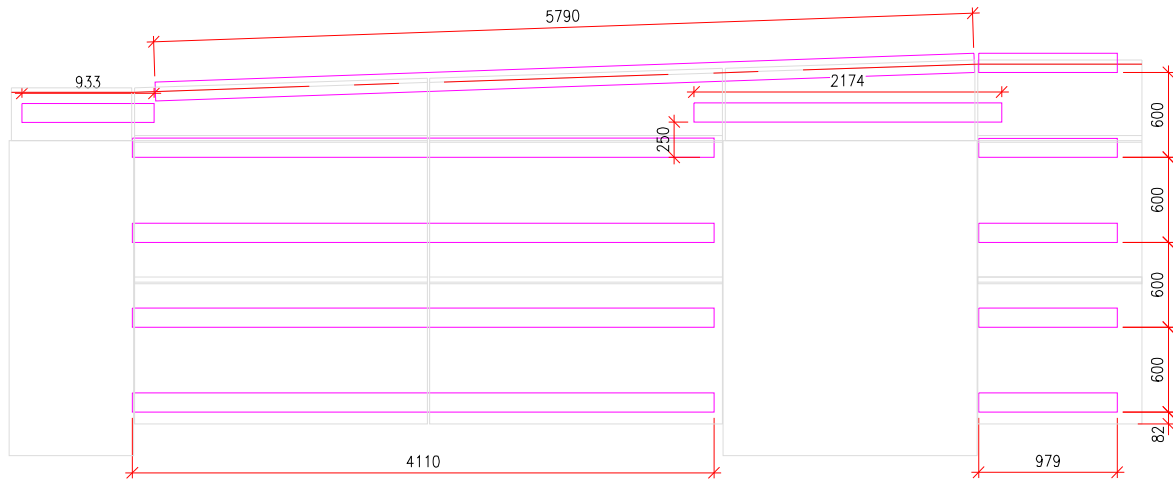

ELE – PH01 – SOUTH – 03

PH01 – EAST – 02

PH01 – EAST – 02

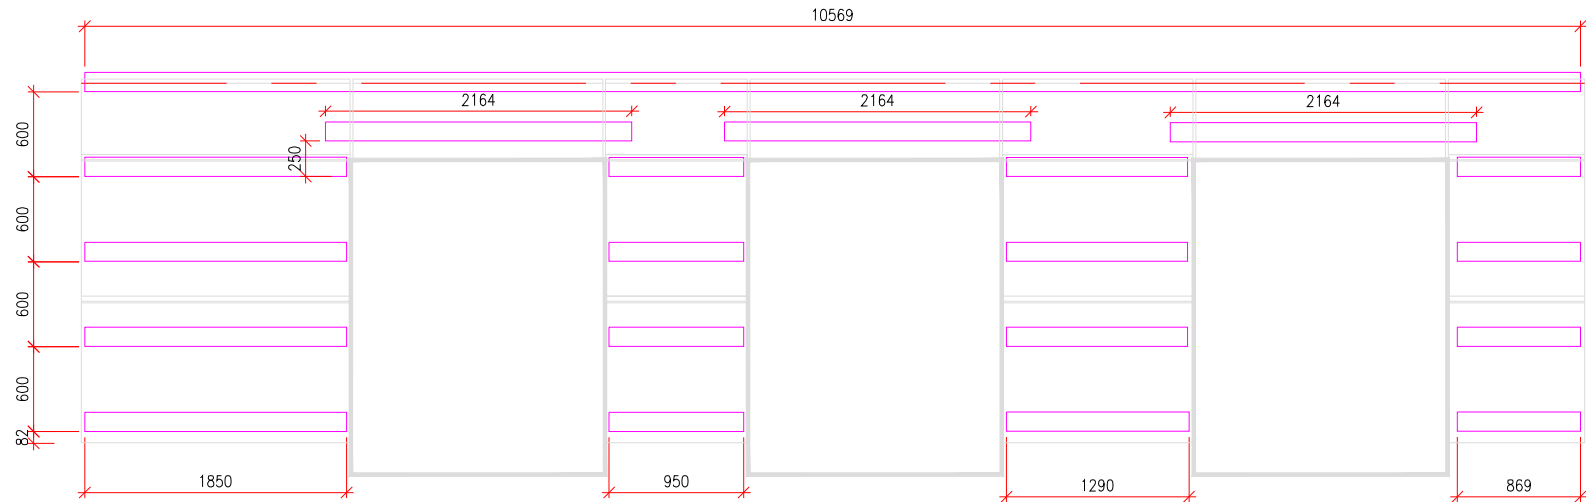

ELE – PH01 – SOUTH – 04


PH01 – EAST – 03

AS BUILT 19/11/21

DESIGNED AND INSTALLED AS PER FASTFRAME DESIGN CALCULATIONS. PLEASE REFER TO FILES; –
'FASTFRAME CALCULATIONS V7 [AB-19-03-21].PDF'
'2020 BUILDING V2 – 202191020 [AB-19-03-21].PDF'
'GENIUS-PRIME-R18122 PRIME TEST DATA (3).PDF'

NOTES

- SUPPORT TRAY 02 (T02) – 135 TRAY
- SUPPORT TRAY 01 (T01) – 210 TRAY

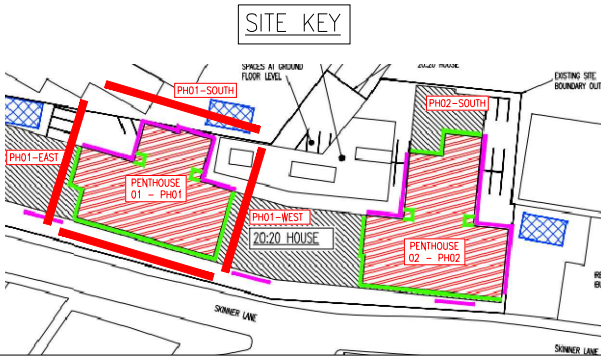

C02	UPDATED AS PER WANTECH EMAIL 18/11/21	RM	18/11/21
C01	CONSTRUCTION ISSUE	RM	29.10.21
P03	UPDATED AS PER WANTECH COMMENTS	RM	24.09.21
P02	TRAY CTRS AMENDED TO V7 CALCS	SA	09.03.21
Rev	Description	By	Date
<div><div></div><div>AJ Cladding LTD Architectural Cladding Specialists</div></div> <div>19A Wilson Street, Hamilton, ML3 0NH +44 (0) 1698 339 104 ajcladding.co.uk info@ajcladding.co.uk</div>			
Drawn By	SA	Date Created	04.01.20
Contract No.	2020		
Contract Title	20: 20 HOUSE		
Drawing Title	PENTHOUSE 01 SOUTH ELEVATION SUPPROT TRAY SETOUTS 01		
Drawing No.	2020-PH01-SOU-BKT-002	Rev	C02