



PH01 – SOUTH –02

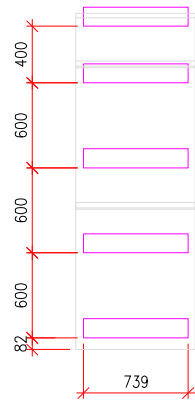

PH01 – SOUTH –03

PH01 – SOUTH –03

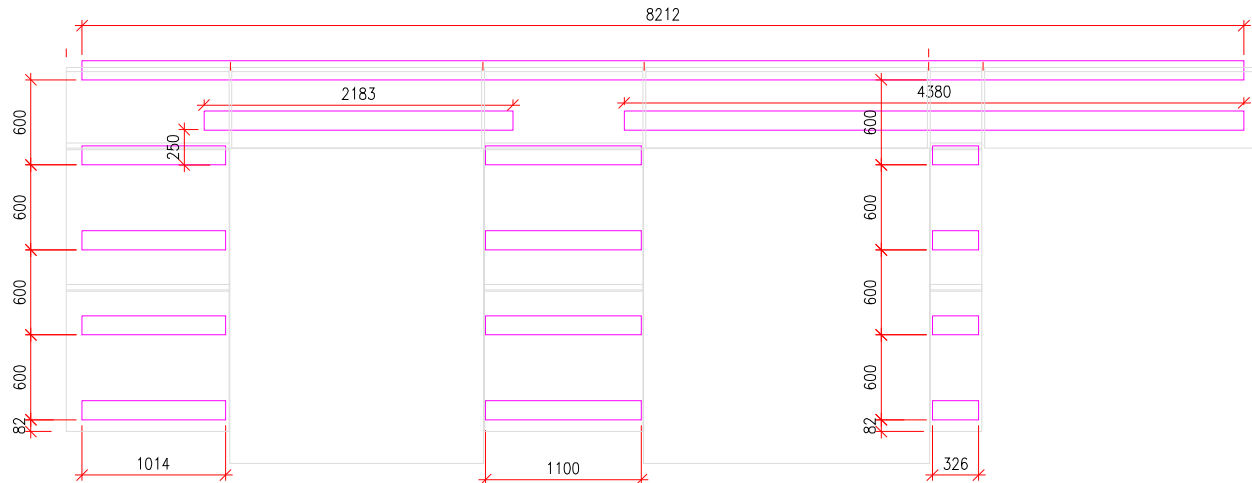


PH01 – SOUTH –04

ELE – PH01 –EAST–01


ELE – PH01 –EAST–02

PH01 – SOUTH –04

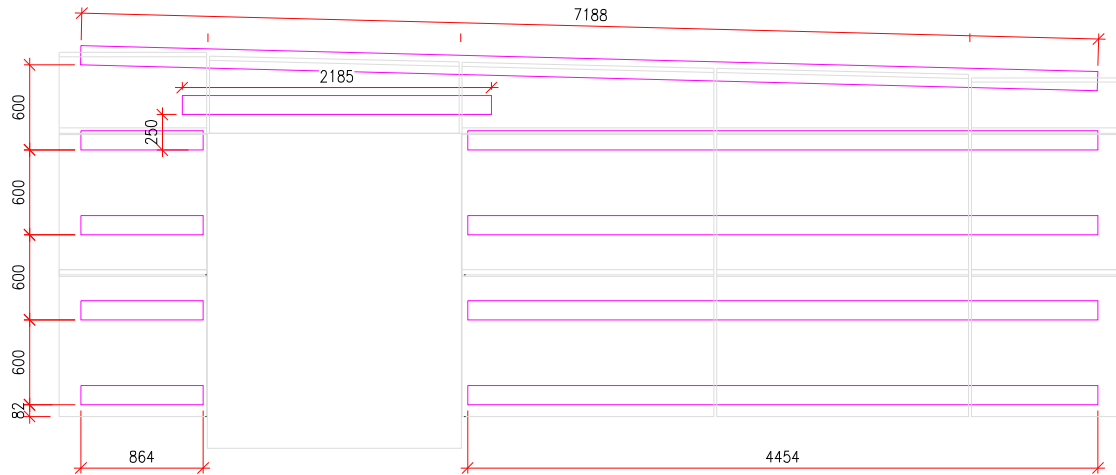

PH01 – NORTH –01

PH01 – NORTH –01

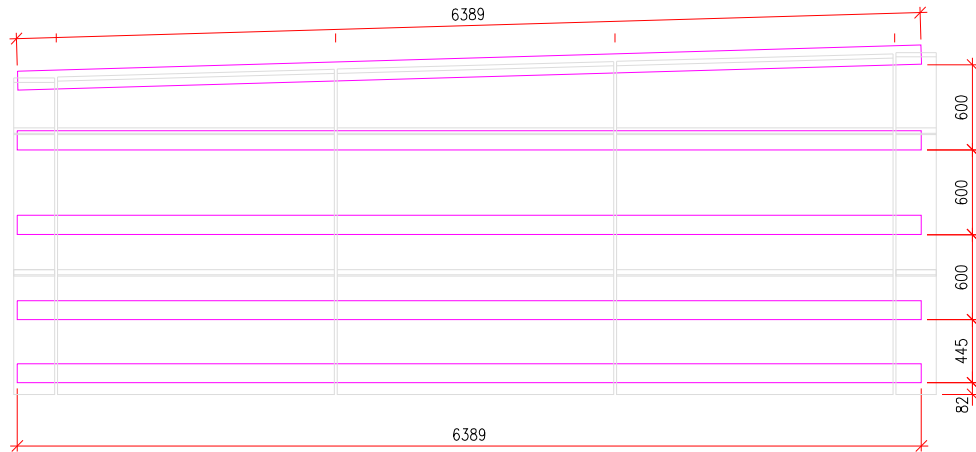



PH01 – NORTH –02

ELE – PH01 –EAST–03


ELE – PH01 –EAST–04

PH01 –EAST –02

PH01 –EAST –02

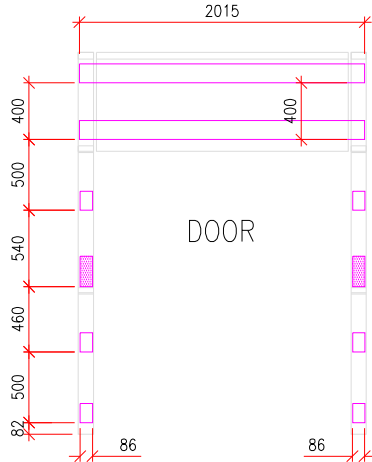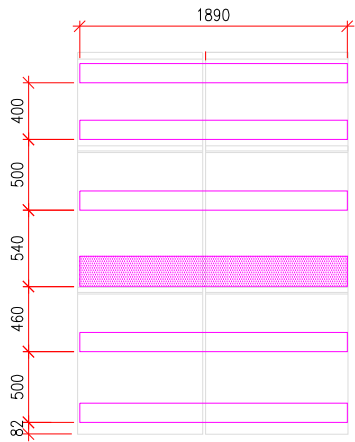 



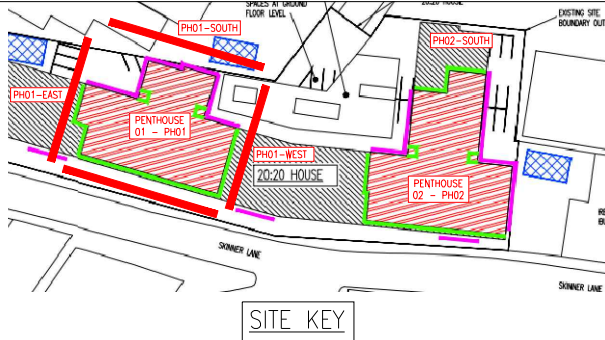
PH01 APT 238  
RECESSED BALCONY

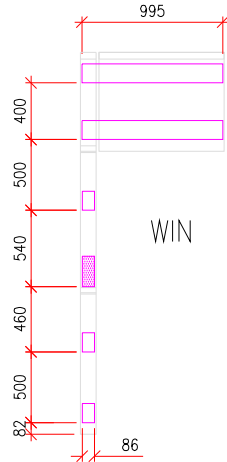

PH01 – SOUTH –04


NOTES

-  SUPPORT TRAY 02 (T02) – 135 TRAY
-  SUPPORT TRAY 01 (T01) – 210 TRAY



DESIGNED AND INSTALLED AS PER FASTFRAME DESIGN CALCULATIONS. PLEASE REFER TO FILES; –  
'FASTFRAME CALCULATIONS V7 [AB-19-03-21].PDF'  
'2020 BUILDING V2 – 202191020 [AB-19-03-21].PDF'  
'GENIUS-PRIME-R18122 PRIME TEST DATA (3).PDF'

AS BUILT 19/11/21

C02	UPDATED AS PER WINTech EMAIL 18/11/21	RM	18/11/21
C01	CONSTRUCTION ISSUE	RM	29.10.21
P04	REVISED AS PER WINTech COMMENTS	RM	24.09.21
P03	TRAY CTRS AMENDED TO V2 CALCS RECESSED BALCONIES	SA	06.05.21
P02	TRAY CTRS AMENDED TO V7 CALCS	SA	09.03.21
Rev	Description	By	Date
<div><div><b>AJ Cladding LTD</b> Architectural Cladding Specialists</div><div>19A Wilson Street, Hamilton, ML3 0NH +44 (0) 1698 339 104 ajcladding.co.uk info@ajcladding.co.uk</div></div>			
Drawn By	SA	Date Created	04.01.20
Contract No.	2020	Scale	NTS
Contract Title	20: 20 HOUSE	ot	A1
Drawing Title	PENTHOUSE 01 EAST ELEVATION SUPPORT TRAY SETOUTS 01		
Drawing No.	2020-PH01-EAS-BKT-002	Rev	C02