



Verge soffit details
(SCALE 1:7.5 @ A3)

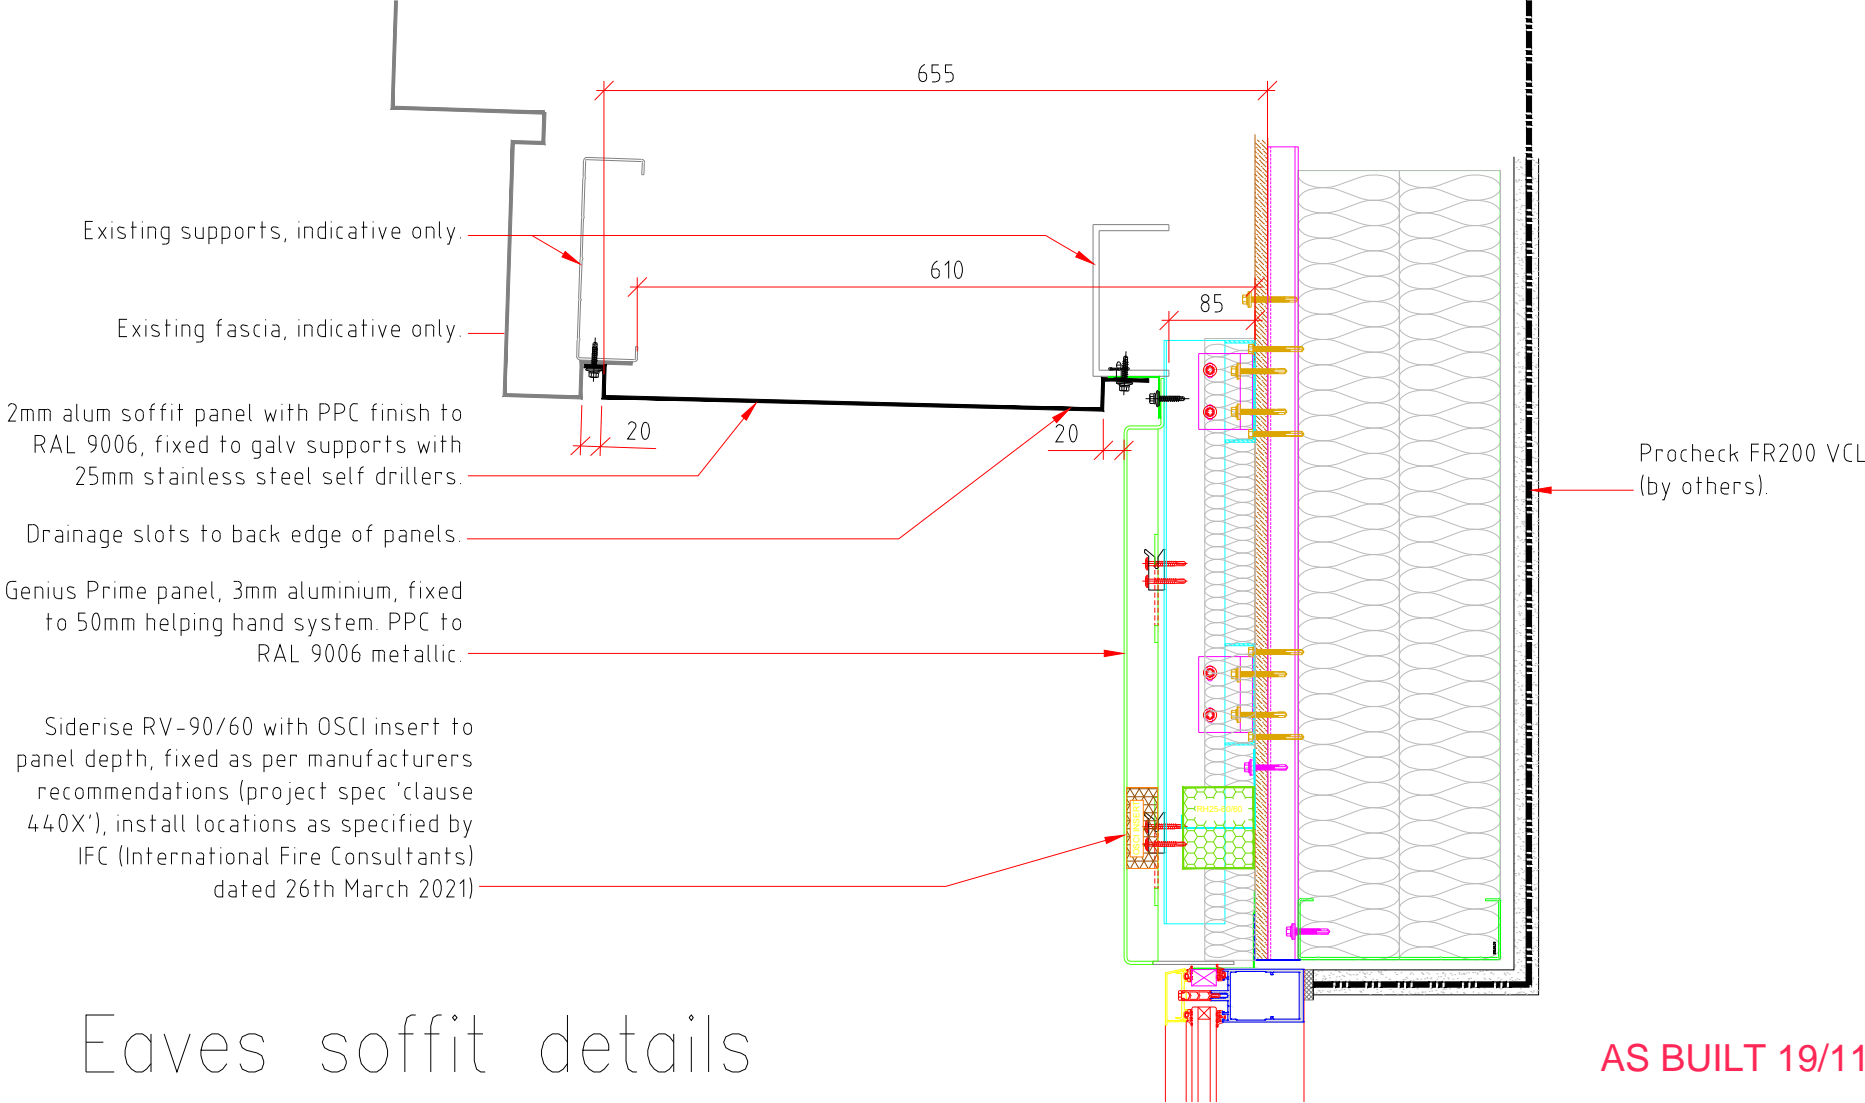

Eaves soffit details
(SCALE 1:7.5 @ A3)

AS BUILT 19/11/21

C01	CONSTRUCTION ISSUE	RM	29/10/21
P04	DRAINAGE SLOT NOTE ADDED.	RM	29/07/21
P03	UPDATED AS PER WINTech COMMENTS 02/07/21	RM	07/07/21
P02	UPDATED AS PER WINTech COMMENTS 17/06/21	RM	28/06/21
P01	FIRST ISSUE	RM	27/05/21
Rev	Description	By	Date
<div><div><div><div>AJ Cladding LTD</div><div>Architectural Cladding Specialists</div></div><div><div>19A Wilson Street, Hamilton, ML3 0NH</div><div>+44 (0) 1698 339 104 ajcladding.co.uk info@ajcladding.co.uk</div></div></div></div>			
Drawn By	RM	Date Created	27/05/21
Contract No.	2020		
Contract Title	20:20 HOUSE		
Drawing Title	PH01 Perimeter soffit details as proposed		
Drawing No.	2020-PH01-FS-017	Rev	C01