



Section on 'A-A'

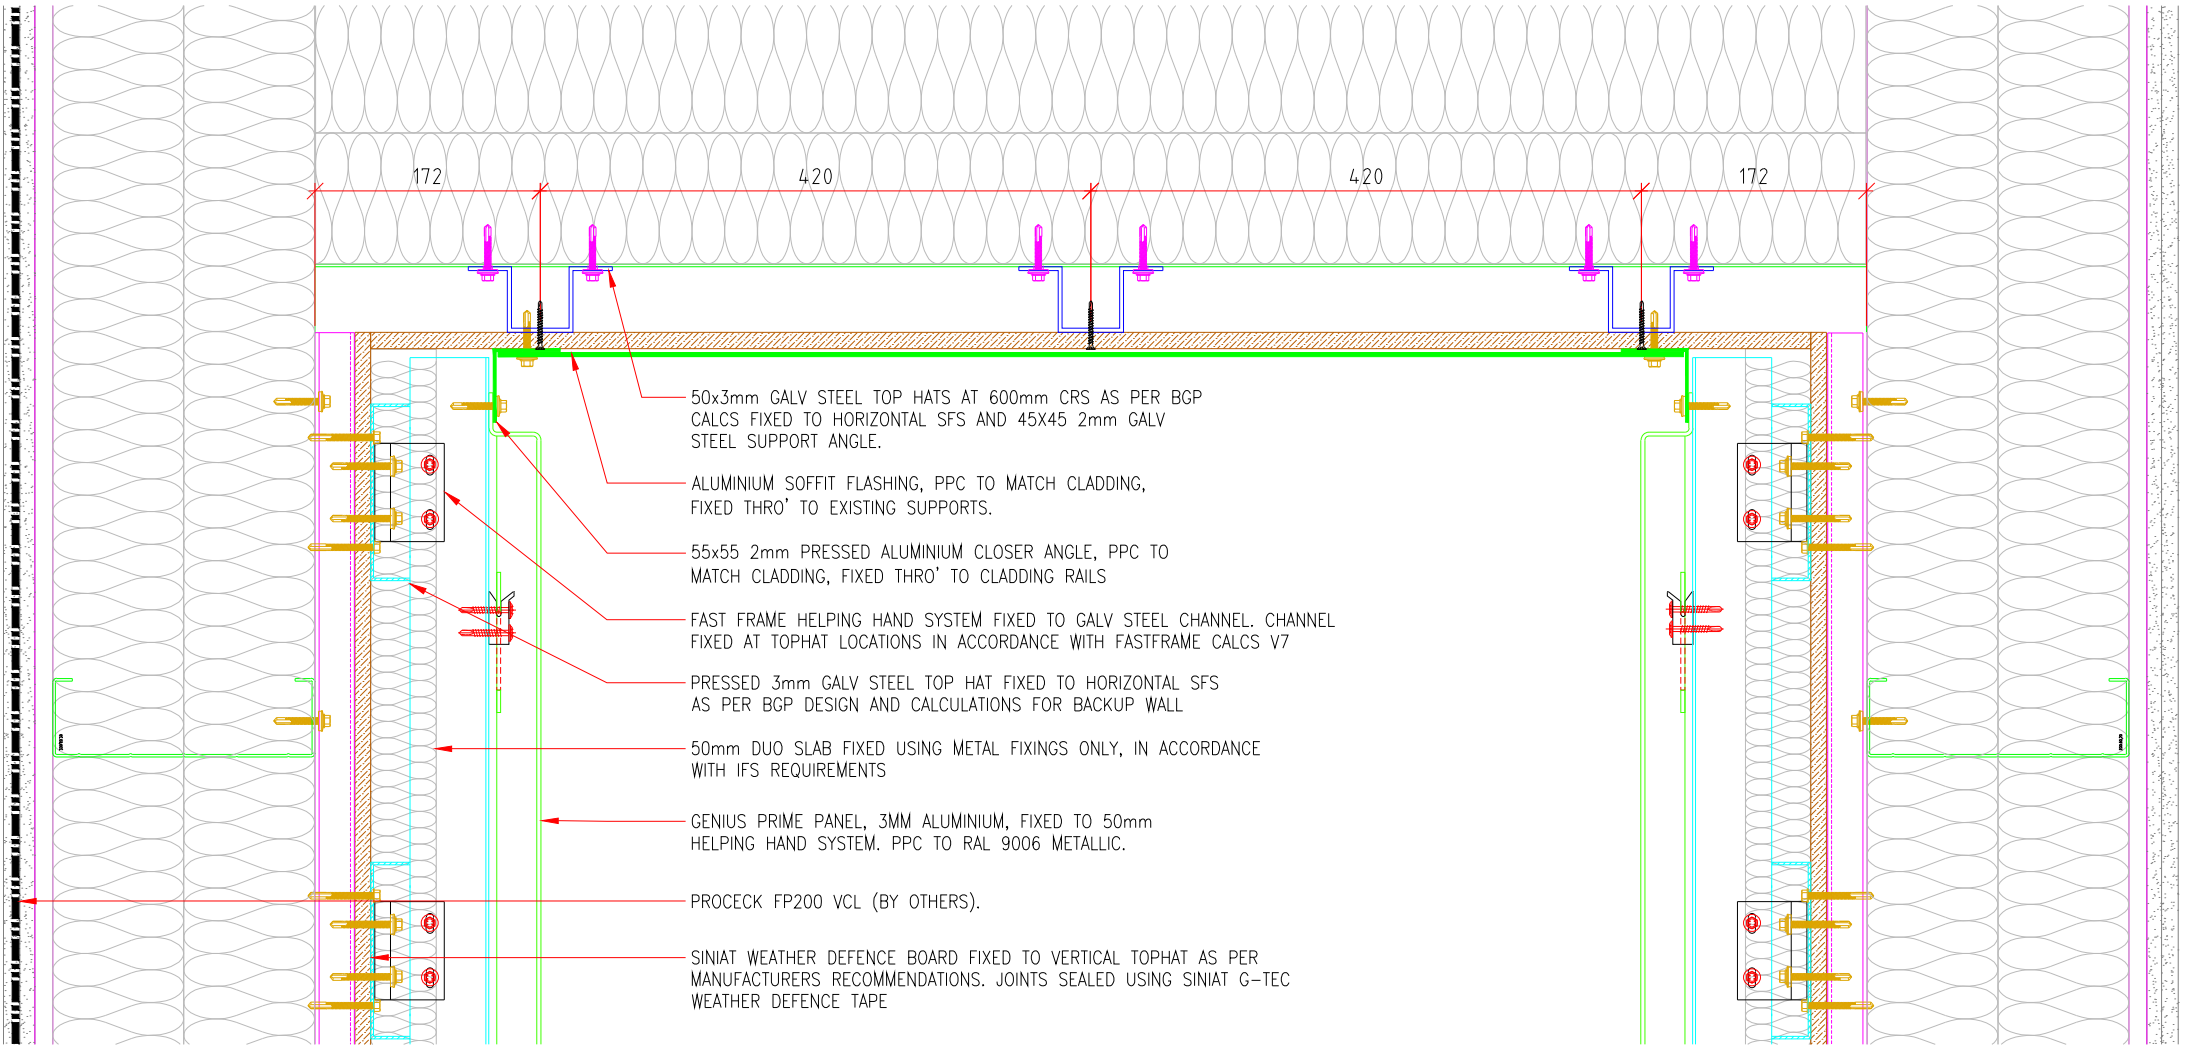


Section on 'B-B'

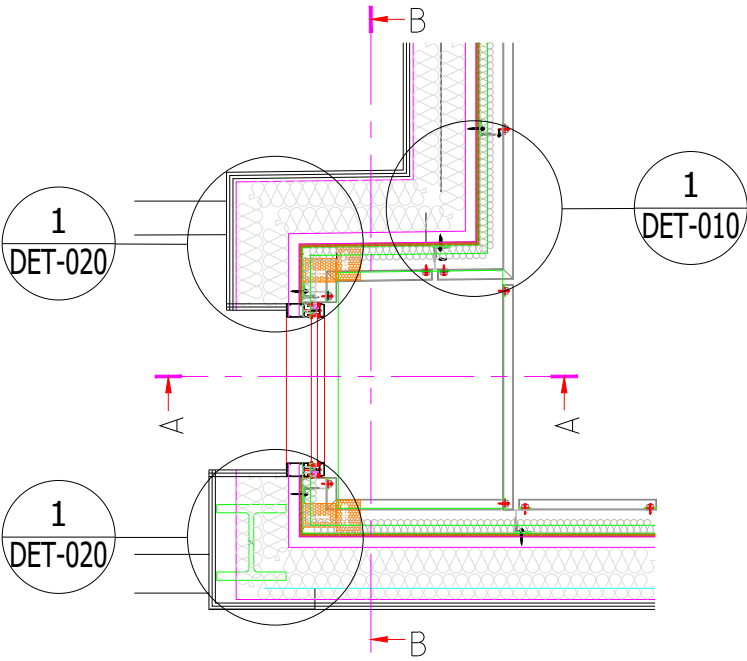

Key Plan (SCALE 1:30 @ A3)

AS BUILT 19/11/21

C03	EPDM AND PFC ADDED.	RM	18/11/21
C02	UPDATED AS PER WINTech COMMENTS	RM	17/11/21
C01	CONSTRUCTION ISSUE	RM	28/10/21
P01	FIRST ISSUE	RM	23/09/21
Rev	Description	By	Date
<div><div><div><div><b>AJ Cladding LTD</b></div><div>Architectural Cladding Specialists</div></div></div><div><div>19A Wilson Street, Hamilton, ML3 0NH</div><div>+44 (0) 1698 339 104 ajcladding.co.uk info@ajcladding.co.uk</div></div></div>			
Drawn By	RM	Date Created	23/09/21
Contract No.	2020	Scale	NTS
Contract Title	20: 20 HOUSE	ot	A3
Drawing Title	PH02 SOUTH ELEVATION DOOR RECESS		
Drawing No.	2020-PH02-DET-023	Rev	C03