



KEY:

○ Denoted Siderise RV-96/60 cavity barrier with OSCI inserts to cladding panel depth.

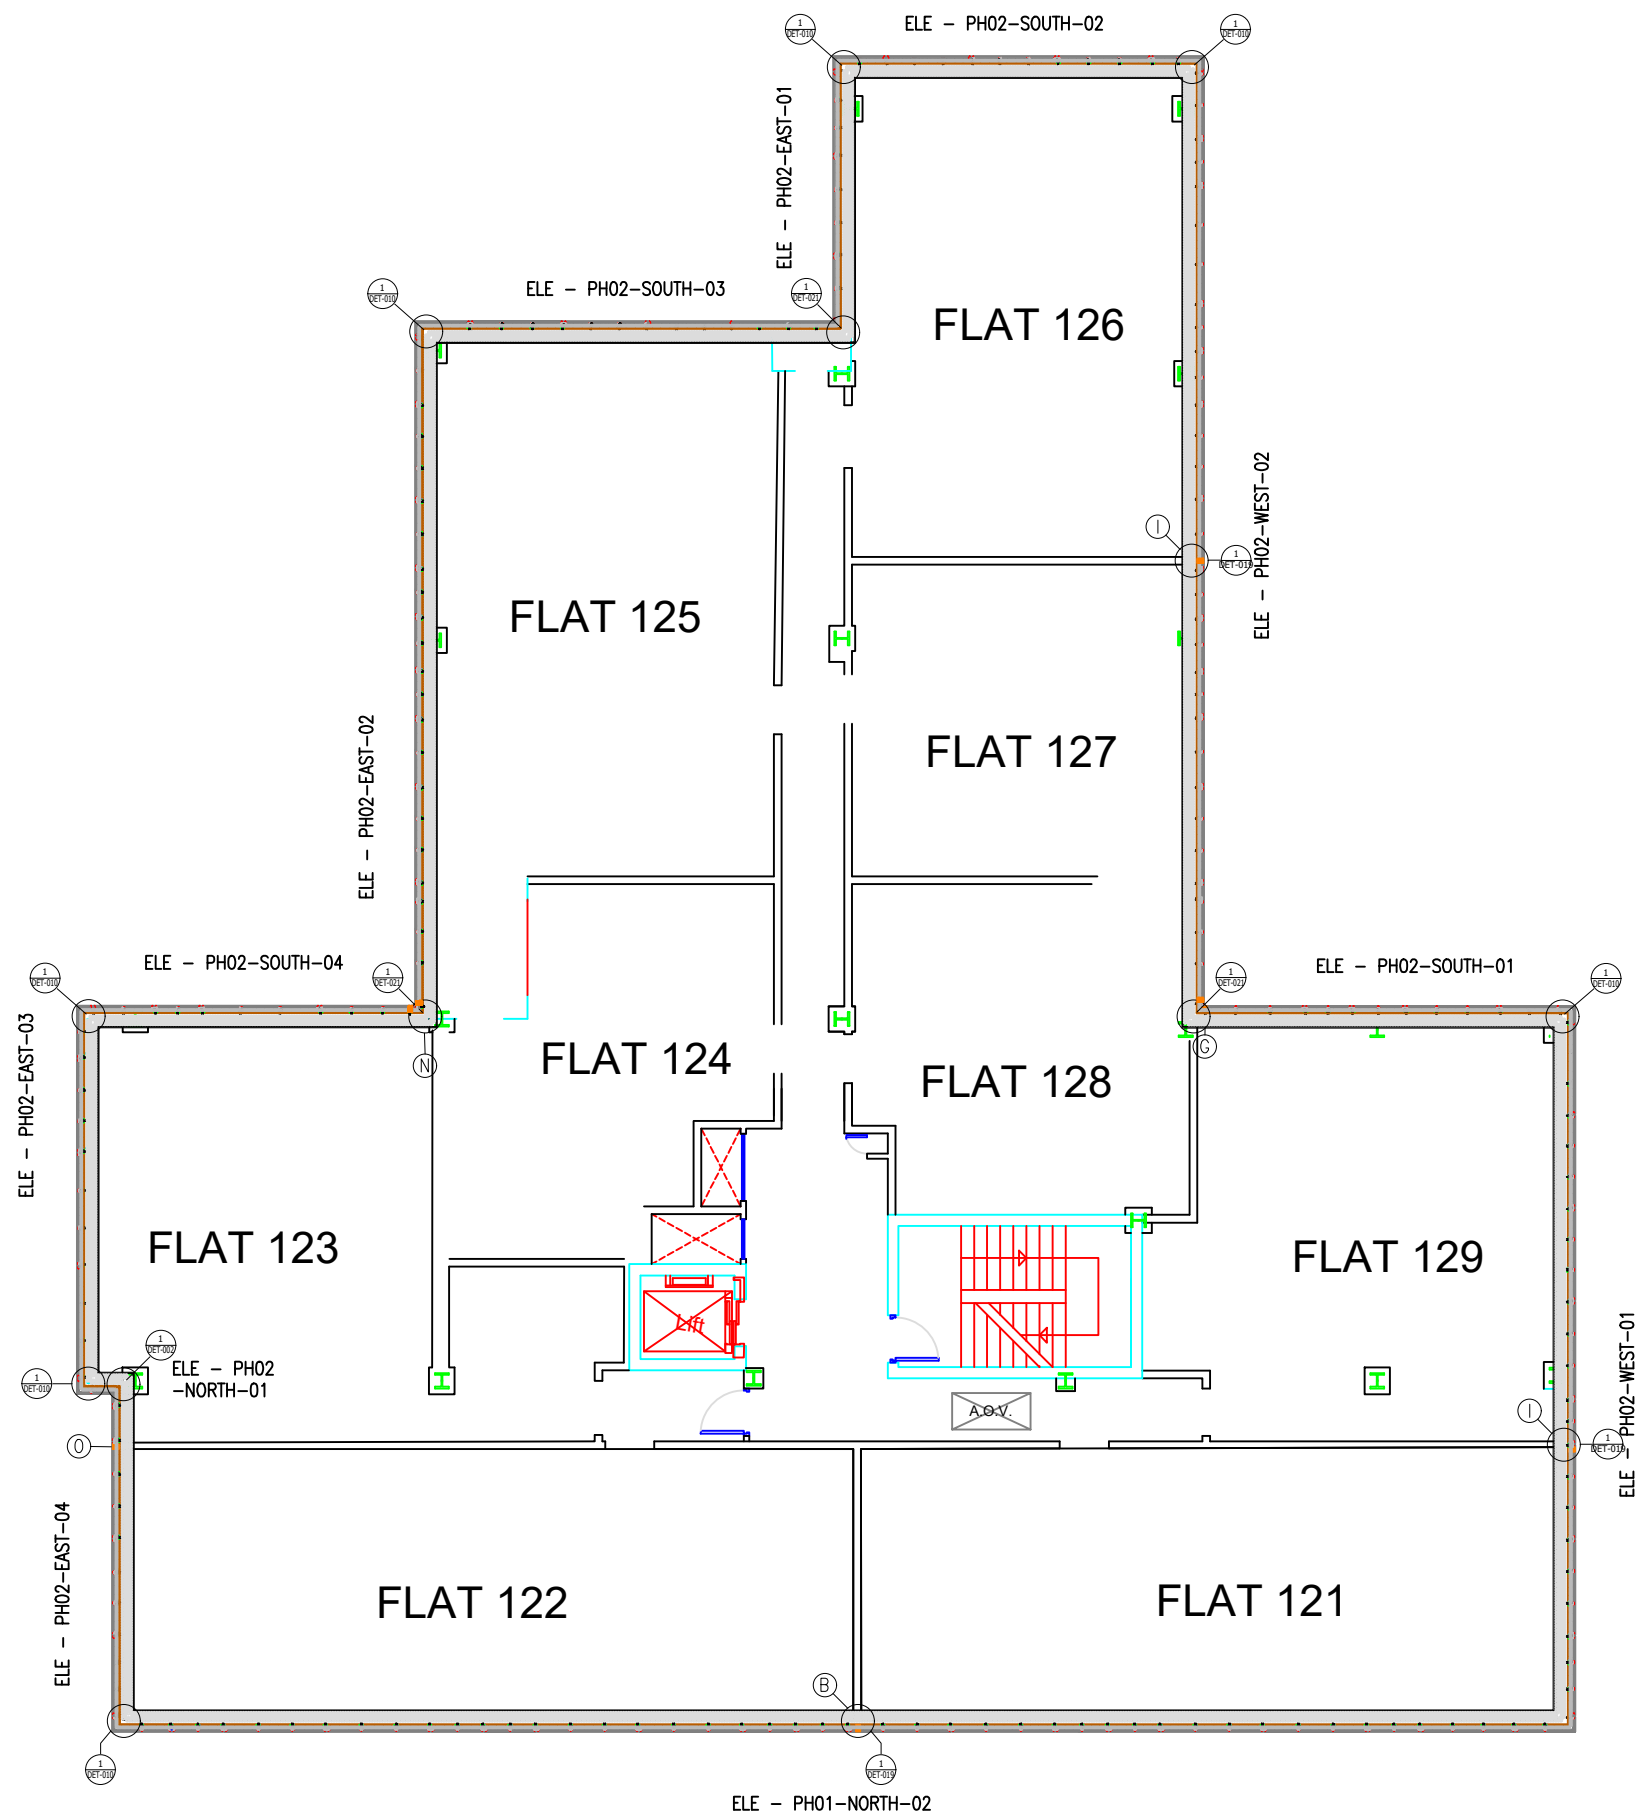

NOTE:
Plan build-up indicative only. Plan to be used for large scale detail locations only.

AS BUILT 19/11/21

C01	CONSTRUCTION ISSUE	RM	28/10/21
P04	UPDATED AS PER WINTech COMMENTS 16/09/21	RM	23/09/21
P03	DETAIL REFS ADDED	RM	13/09/21
P02	ISSUE NOTE ADDED	RM	23/06/21
P01	FIRST ISSUE	RM	17/05/21
Rev	Description	By	Date
<div><div><div><div>AJ Cladding LTD</div><div>Architectural Cladding Specialists</div></div><div><div>19A Wilson Street, Hamilton, ML3 0NH</div><div>+44 (0) 1698 339 104 ajcladding.co.uk info@ajcladding.co.uk</div></div></div></div>			
Drawn By	RM	Date Created	17/05/21
Contract No.	2020	Scale	1:150 at A3
Contract Title	20: 20 HOUSE		
Drawing Title	FIRE STRATEGY – HIGH LEVEL PLAN		
Drawing No.	2020-PH02-FS-002	Rev	C01