

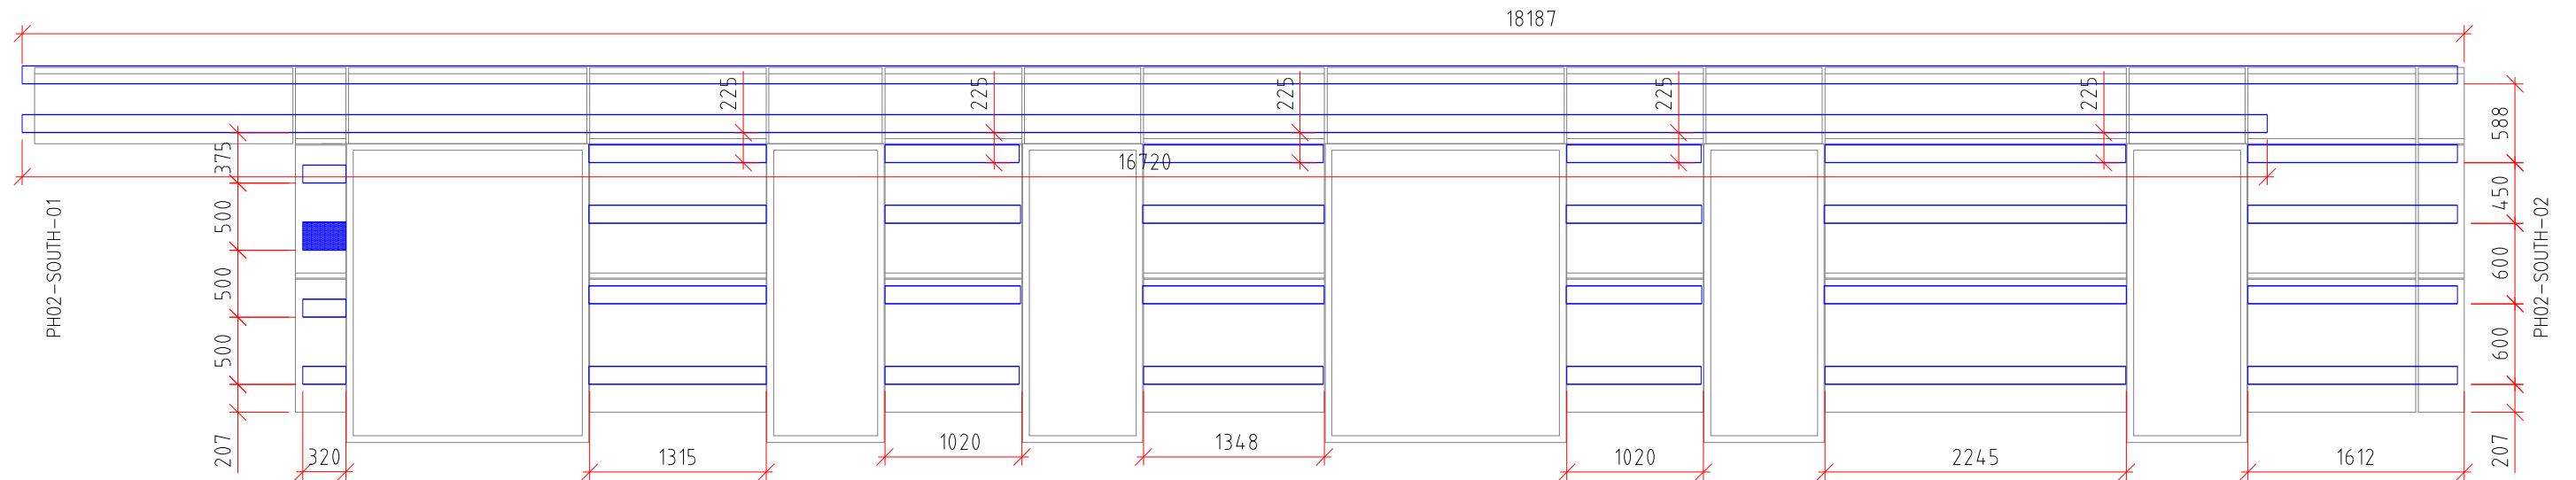
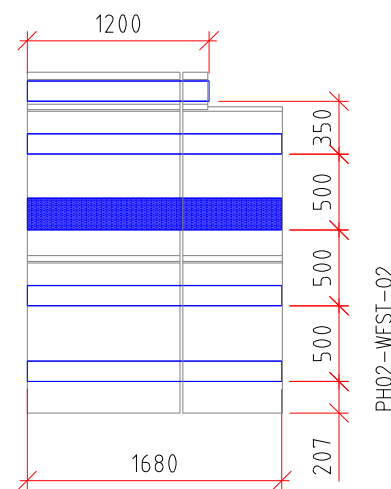


ELE - PH-WEST-01

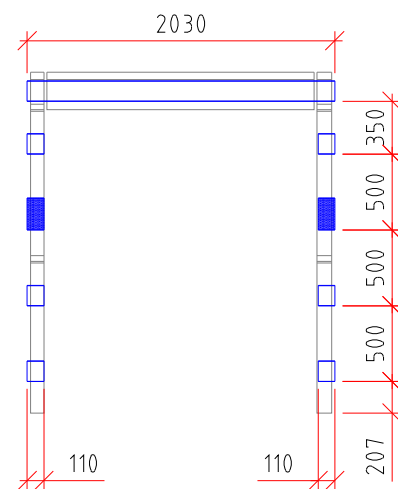


ELE - PH-WEST-02

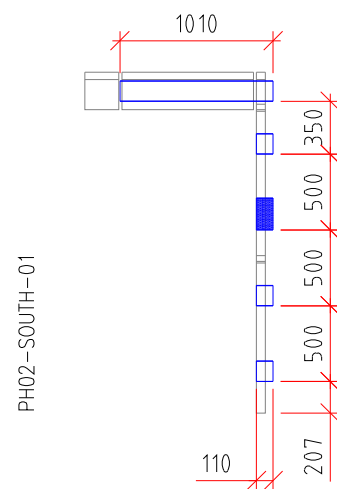

- 135x30 2mm GALV CHANNEL
- 200x30 2mm GALV CHANNEL

DESIGNED AND INSTALLED AS PER FASTFRAME DESIGN CALCULATIONS. PLEASE REFER TO FILES; -  
 '2020 HOUSE - PENTHOUSE NO. 2 - STEEL - VERTICAL FACADE - 90MM - GENIUS PRIME - 202041021\_V1.PDF'  
 '2020 BUILDING - RECESS BALCONIES - STEEL - VERTICAL FACADE - 90MM - GENIUS PRIME - 202041021\_V1.PDF'

AS BUILT 19/11/21

C01	CONSTRUCTION ISSUE	RM	28/10/21
P05	SET-OUT REVISED (SEE REV CLOUD)	RM	15/10/21
P04	UPDATED AS PER WINTECH COMMENTS 30/09/21	RM	01/10/21
P03	UPDATED AS PER WINTECH COMMENTS 16/09/21	RM	23/09/21
P02	SET-OUT HEIGHTS REVISED.	RM	26/08/21
P01	FIRST ISSUE	SA	09/07/21
Rev	Description	By	Date
<div>  <div> 19A Wilson Street, Hamilton, ML3 0NH   +44 (0) 1698 339 104  ajcladding.co.uk  info@ajcladding.co.uk </div> </div>			
Drawn By	SA	Date Created	09/07/21
Contract No.	2020		
Contract Title	20: 20 HOUSE		
Drawing Title	PENTHOUSE 02 WEST ELEVATION GALV CHANNEL SETOUTS 02		
Drawing No.	2020-PH02-CH-002	Rev	C01

PH02 APT 128  
RECESSED BALCONY