



ELE - PH01-EAST-01

ELE - PH01-EAST-02

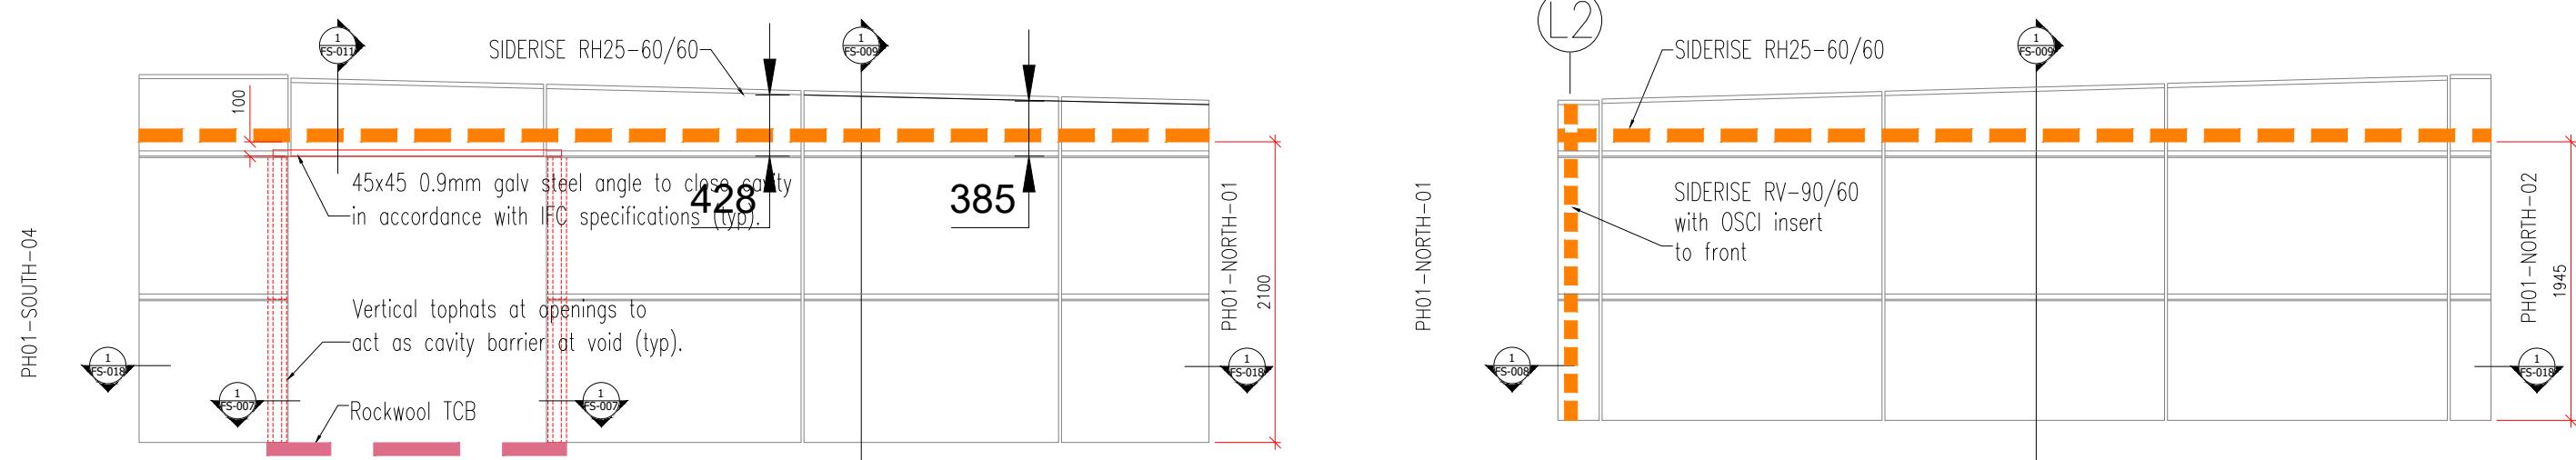


ELE - PH01-EAST-03

ELE - PH01-EAST-04

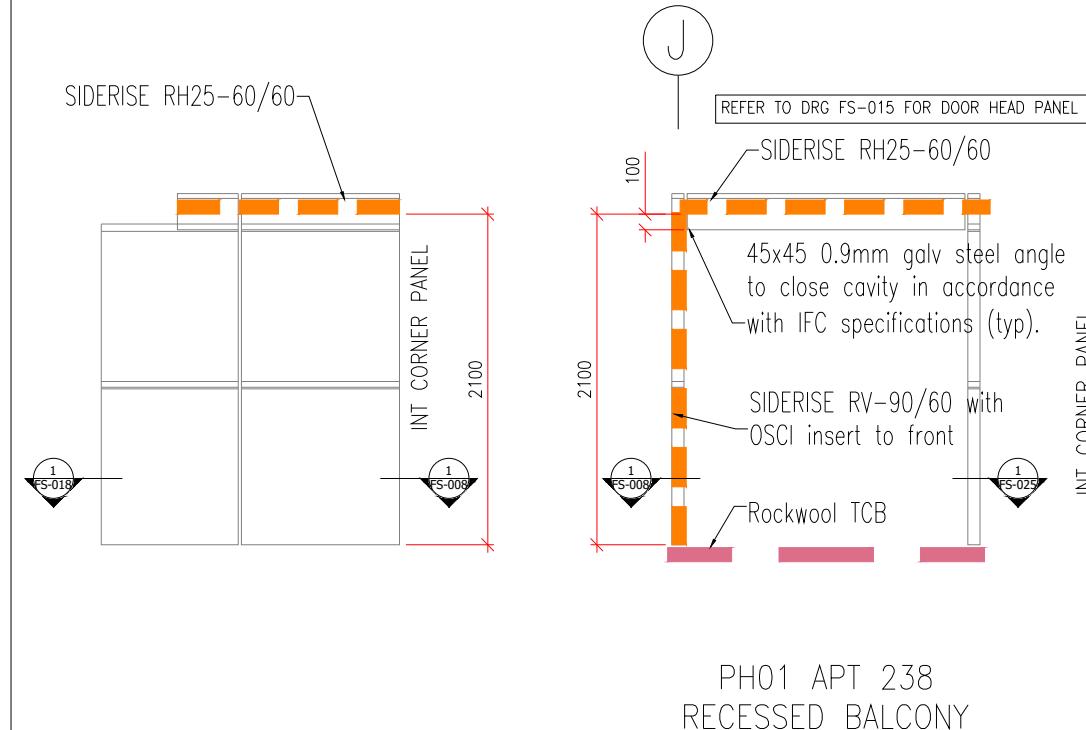

PH01 APT 238
RECESSED BALCONY

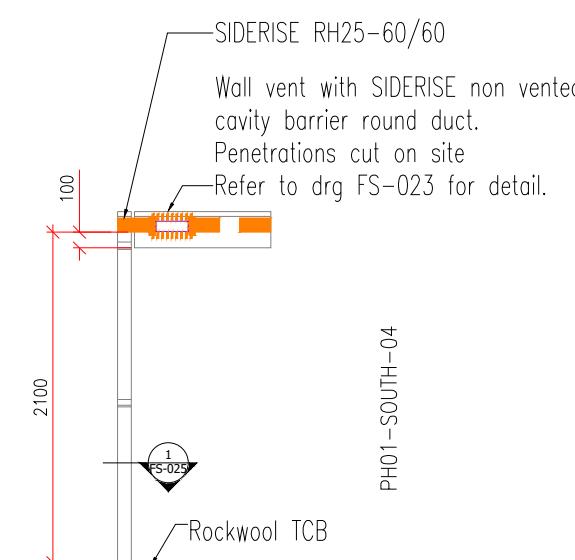

- Denotes Siderise RH25–60/60 horizontal cavity barriers run continuously round building, typically 100mm above window openings.

■ Denotes Siderise RV-90/60 cavity barrier with OSCI inserts to cladding panel depth.

- Denotes Rockwool TCB cavity barrier. To be installed from inside flats by others at every window and door. Barriers to extend 150mm past openings.

 Denoted Siderise RV-90/60 cavity barrier with OSC1 inserts to cladding panel depth round wall vent ducting.

CAVITY BARRIERS AND FIRE STRATEGY
SUPPLIED AND INSTALLED IN
ACCORDANCE WITH THE REQUIREMENTS
OF IFC SPECIFICATIONS

C02	UPDATED AS PER WINTECH EMAIL 18/11/21			RM	18/11/21	
C01	CONSTRUCTION ISSUE			RM	29/10/21	
P06	UPDATED AS PER WINTECH COMMENTS 02/07/21			RM	07/07/21	
P05	GENERAL UPDATES			RM	22/06/21	
P04	UPDATED AS PER WINTECH COMMENTS 18/05/21			RM	28/05/21	
P03	UPDATED TO SHOW ROCKPANEL RAINSCREEN			RM	15/05/21	
P02	UPDATED AS PER WINTECH COMMENTS 22/04/21			RM	03/05/21	
P01	FIRST ISSUE			RM	21/04/21	
Rev	Description				By	Date
				19A Wilson Street, Hamilton, ML3 0NH		
AJ Cladding LTD Architectural Cladding Specialists				+44 (0) 1698 339 104 ajcladding.co.uk info@ajcladding.co.uk		
Drawn By	RM	Date Created	21/04/21	Scale	1:50	at A3
Contract No.	2020					
Contract Title	20: 20 HOUSE					
Drawing Title	PENTHOUSE 01 EAST ELEVATION CAVITY BARRIER LAYOUT					
Drawing No.	2020-PH01-FS-006			Rev	C02	

AJ Cladding LTD
Architectural Cladding Specialists

144 (0) 1653 333 104
ajcladding.co.uk
info@ajcladding.co.uk

AS BUILT 19/11/21