



ELE - PH01-SOUTH-01

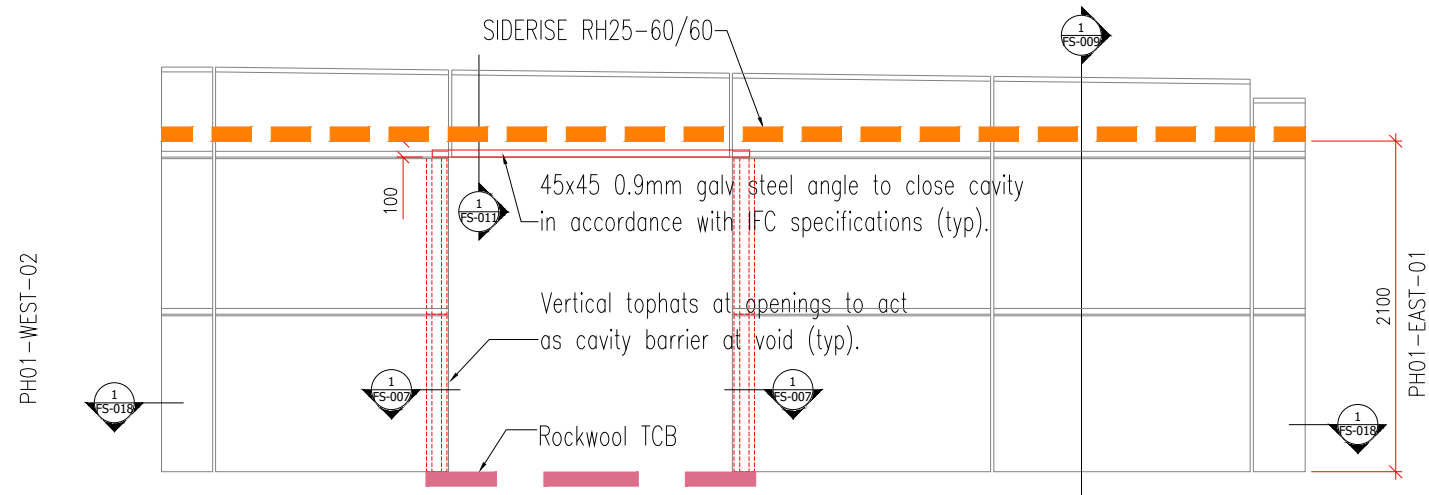


ELE - PH01-SOUTH-02

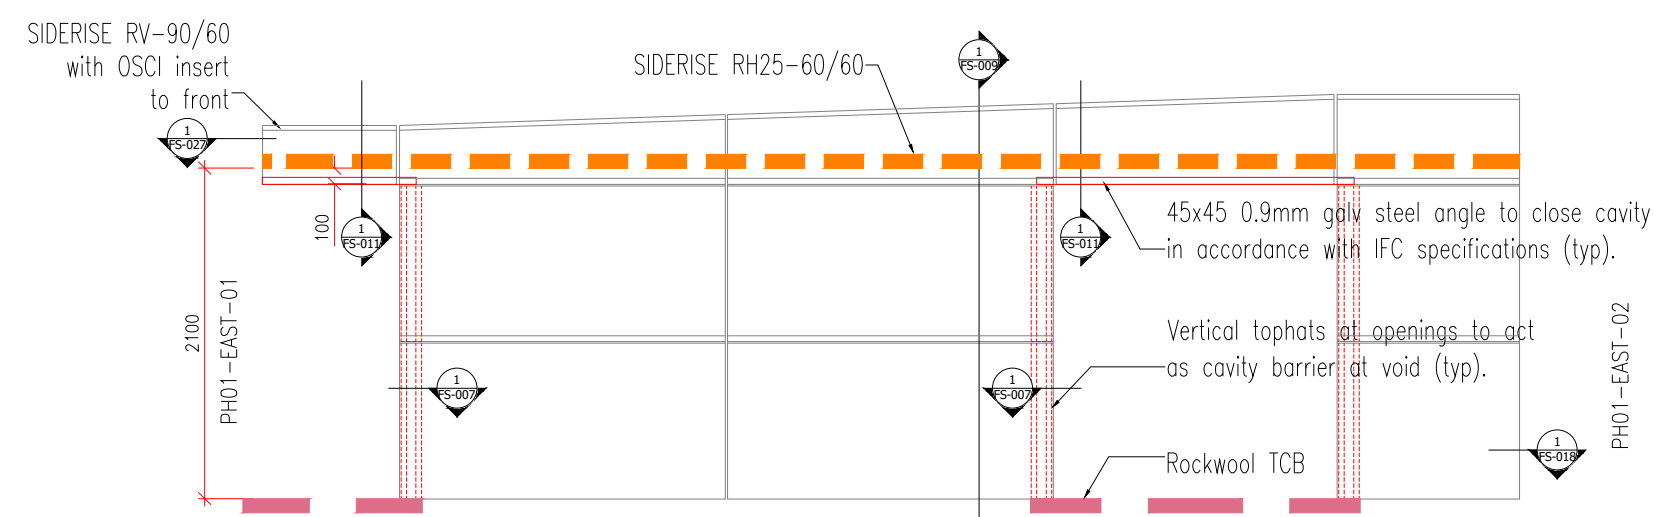

ELE - PH01-SOUTH-03

- Denotes Siderise RH25-60/60 horizontal cavity barriers run continuously round building, typically 100mm above window openings.
- Denotes Siderise RV-90/60 cavity barrier with OSCI inserts to cladding panel depth.
- Denotes Rockwool TCB cavity barrier. To be installed from inside flats by others at every window and door. Barriers to extend 150mm past openings.
- Denoted Siderise RV-90/60 cavity barrier with OSCI inserts to cladding panel depth round wall vent ducting.

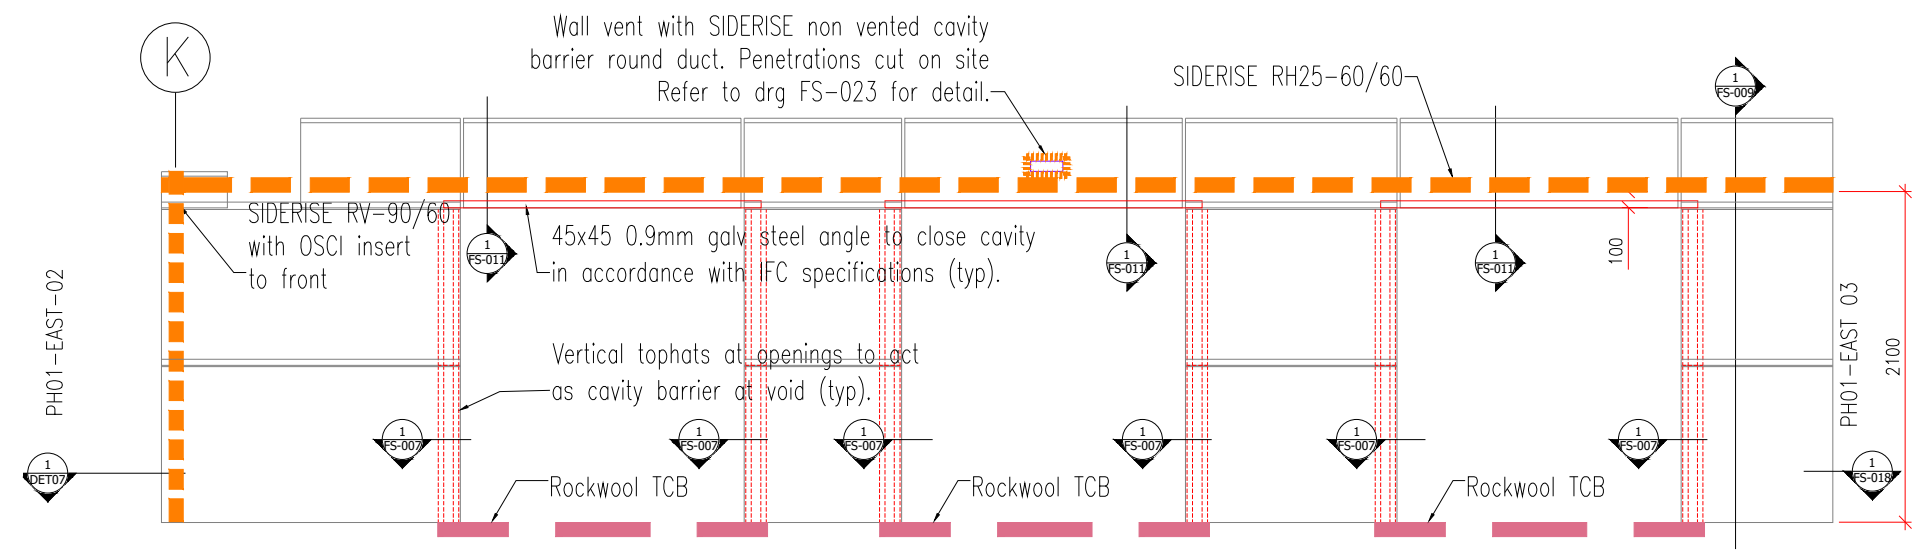

ELE - PH01-SOUTH-04

CAVITY BARRIERS AND FIRE STRATEGY SUPPLIED AND INSTALLED IN ACCORDANCE WITH THE REQUIREMENTS OF IFC SPECIFICATIONS.

C02	UPDATED AS PER WINTECH EMAIL 18/11/21	RM	18/11/21
C01	CONSTRUCTION ISSUE	RM	29/10/21
P06	UPDATED AS PER WINTECH COMMENTS 02/07/21	RM	07/07/21
P05	UPDATED AS PER WINTECH COMMENTS 17/06/21	RM	28/06/21
P04	GENERAL UPDATES	RM	22/06/21
P03	UPDATED AS PER WINTECH COMMENTS 18/05/21	RM	28/05/21
P02	UPDATED AS PER WINTECH COMMENTS 22/04/21	RM	03/05/21
P01	FIRST ISSUE	RM	21/04/21
Rev	Description	By	Date
<div> <div> AJ Cladding LTD Architectural Cladding Specialists </div> </div> <div style="float: right; text-align: right;"> 19A Wilson Street, Hamilton, ML3 0NH +44 (0) 1698 339 104 ajcladding.co.uk info@ajcladding.co.uk </div>			
Drawn By	RM	Date Created	21/04/21
Contract No.	2020		
Contract Title	20: 20 HOUSE		
Drawing Title	PENTHOUSE 01 SOUTH ELEVATION CAVITY BARRIER LAYOUT		
Drawing No.	2020-PH01-FS-005	Rev	C02

AS BUILT 19/11/21