



Section on 'A-A'

(SCALE 1:10 @ A3)

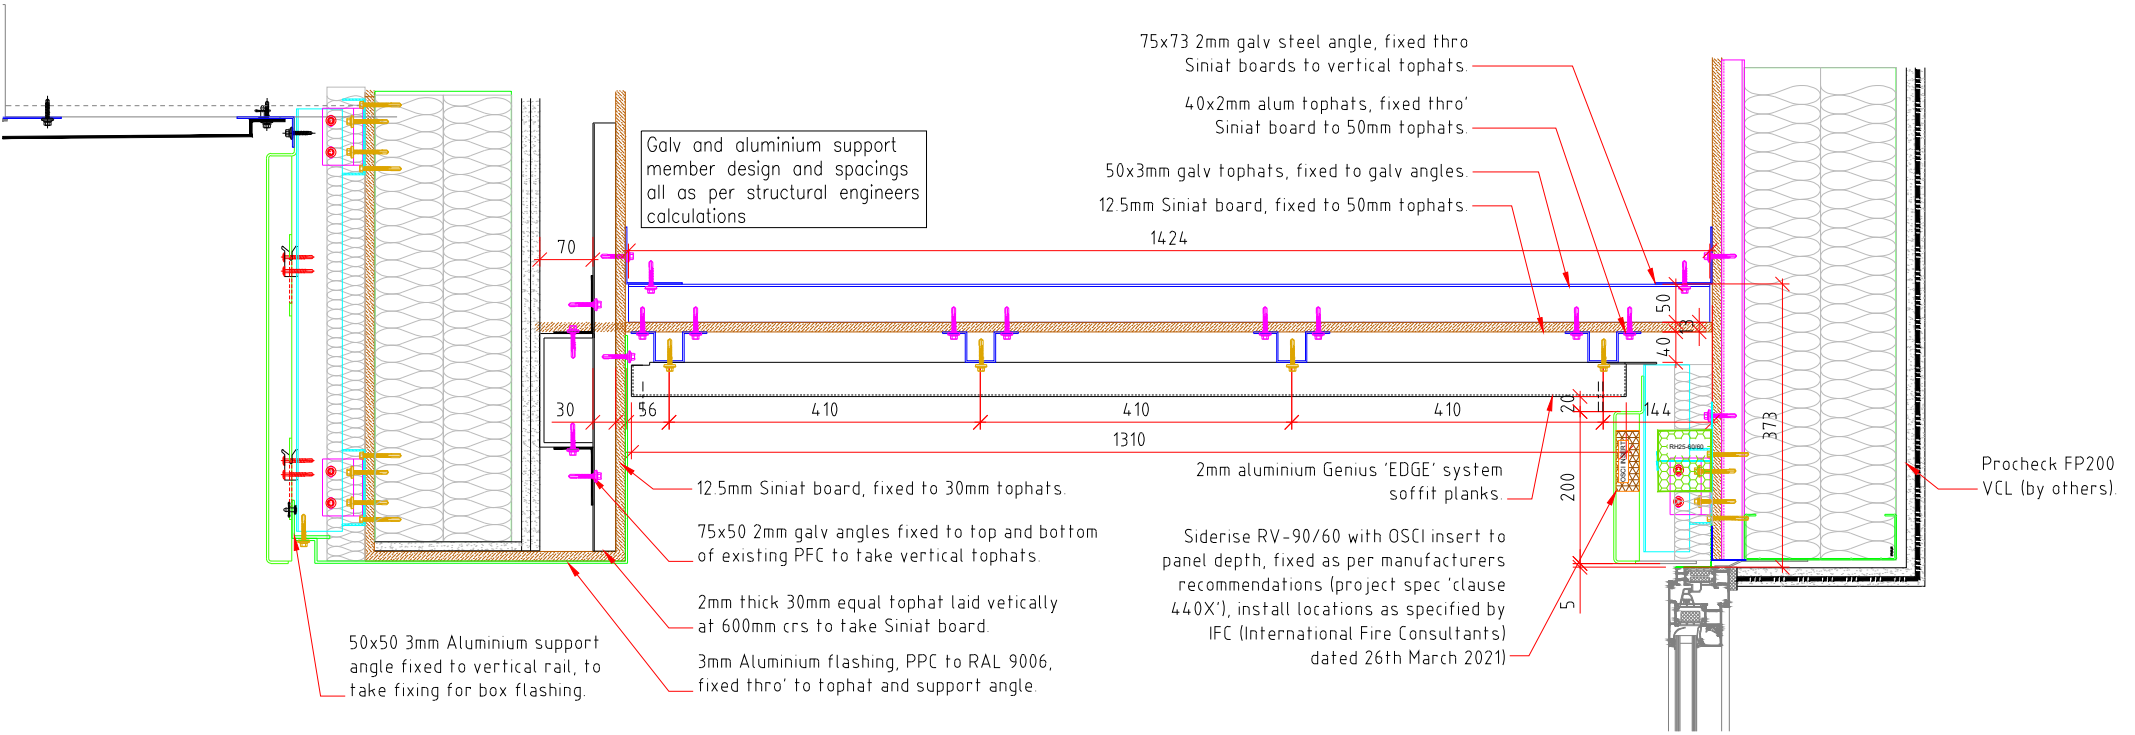

Section on 'B-B'

(SCALE 1:10 @ A3)

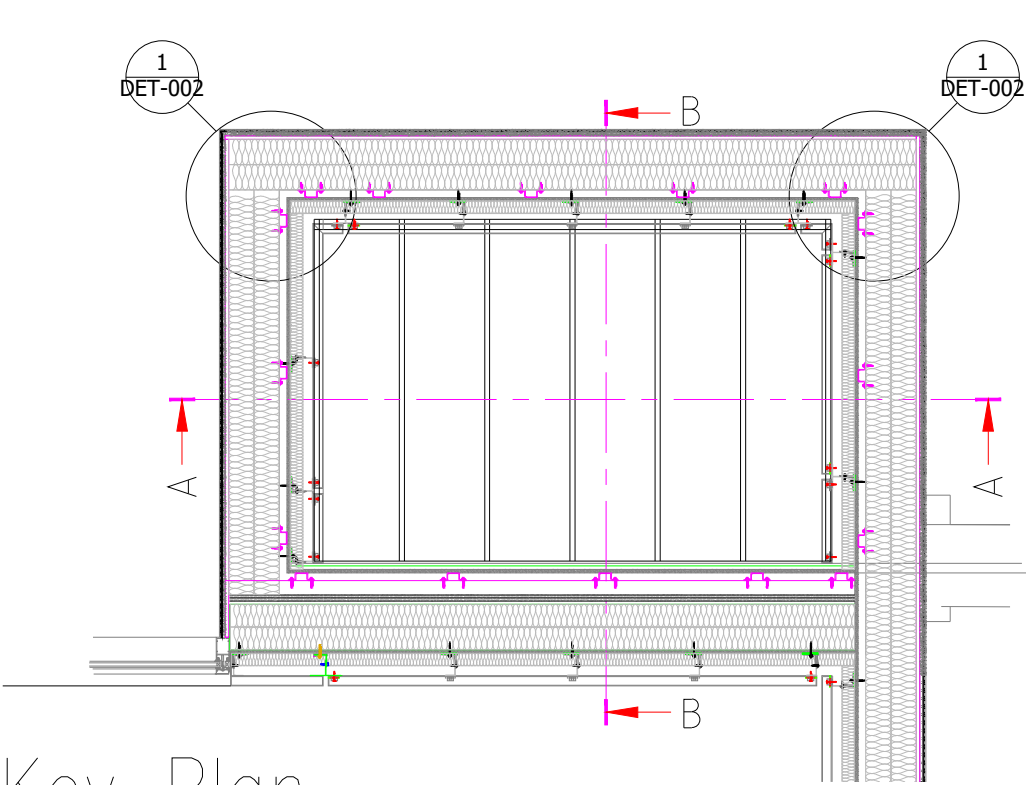

Key Plan

(SCALE 1:30 @ A3)

WALL BUILD-UP INDICATIVE ONLY. PLAN FOR
DETAIL LOCATION PURPOSES ONLY. SEE
DETAILS ABOVE FOR CONSTRUCTION DETAILS.

AS BUILT 19/11/21

C01	CONSTRUCTION ISSUE	RM	28/10/21
P04	UPDATED AS PER WINTech COMMENTS 30/09/21	RM	01/10/21
P03	UPDATED AS PER WINTech COMMENTS 16/09/21	RM	23/09/21
P02	GENERAL UPDATES	RM	23/09/21
P01	FIRST ISSUE	RM	02/09/21
Rev	Description	By	Date
 AJ Cladding LTD Architectural Cladding Specialists 19A Wilson Street, Hamilton, ML3 0NH +44 (0) 1698 339 104 ajcladding.co.uk info@ajcladding.co.uk			
Drawn By	RM	Date Created	02/09/21 Scale NOTED at A3
Contract No.	2020		
Contract Title	20:20 HOUSE		
Drawing Title	PH02 Recess 124 soffit details.		
Drawing No.	2020-PH02-DET-007	Rev	C01