


Detail 1 – Section on 'A-A'


(SCALE 1:10 @ A3)

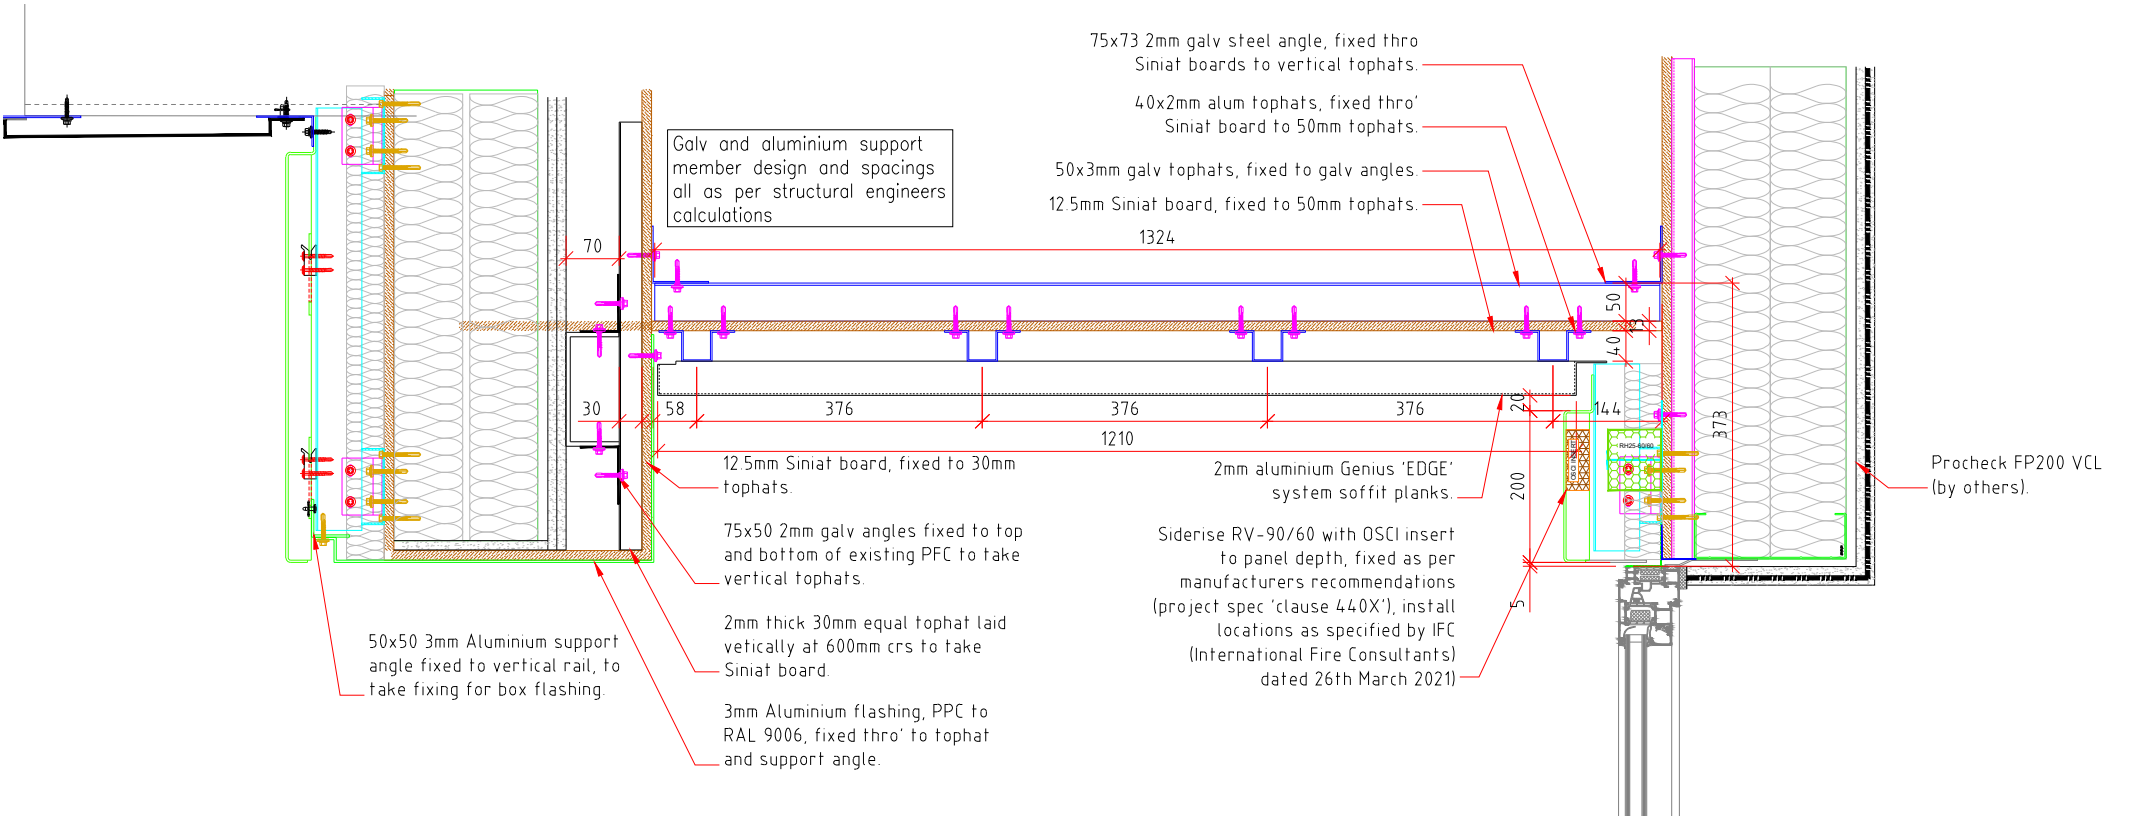

Detail 2 – Section on 'B-B'

(SCALE 1:10 @ A3)


WALL BUILD-UP INDICATIVE ONLY. PLAN FOR  
DETAIL LOCATION PURPOSES ONLY. SEE  
DETAILS ABOVE FOR CONSTRUCTION DETAILS.

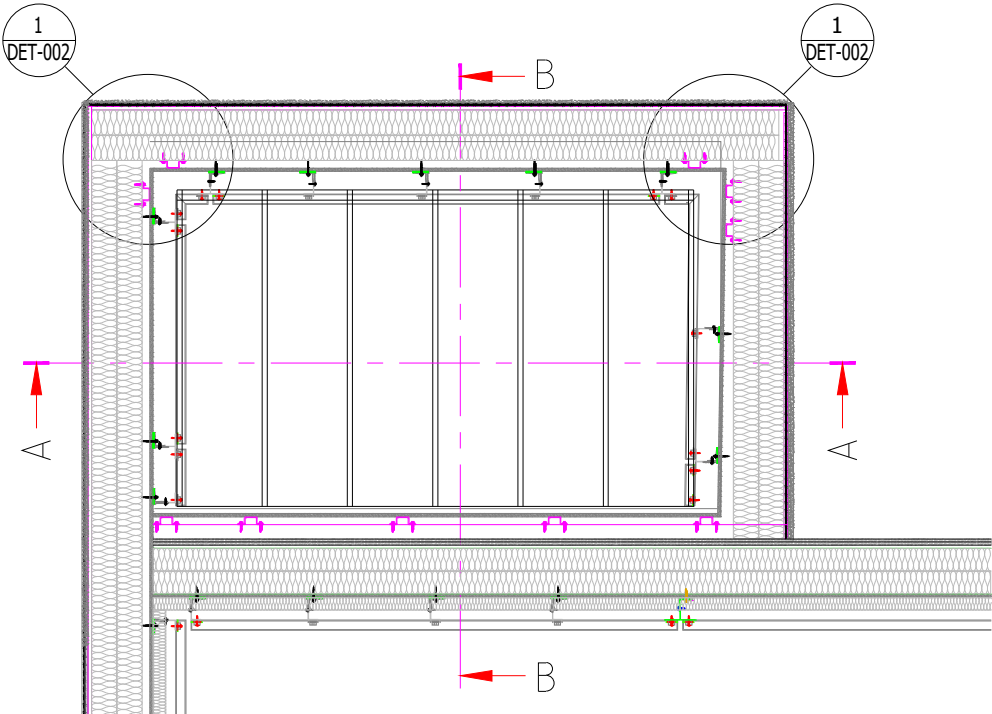

Key Plan

(SCALE 1:30 @ A3)

AS BUILT 19/11/21

|  |  |              |          |       |       |       |
|--|--|--------------|----------|-------|-------|-------|
| C01  | CONSTRUCTION ISSUE                       | RM           | 28/10/21 |       |       |       |
| P04  | UPDATED AS PER WINTECH COMMENTS 30/09/21 | RM           | 01/10/21 |       |       |       |
| P03  | UPDATED AS PER WINTECH COMMENTS 16/09/21 | RM           | 23/09/21 |       |       |       |
| P02  | GENERAL UPDATES                          | RM           | 23/09/21 |       |       |       |
| P01  | FIRST ISSUE                              | RM           | 02/09/21 |       |       |       |
| Rev  | Description                              | By           | Date     |       |       |       |
| <div><div><div><div><b>AJ Cladding LTD</b></div><div>Architectural Cladding Specialists</div></div></div><div>19A Wilson Street,<br/>Hamilton,<br/>ML3 0NH<br/><br/>+44 (0) 1698 339 104<br/>ajcladding.co.uk<br/>info@ajcladding.co.uk</div></div> |  |              |          |       |       |       |
|  |  |              |          |       |       |       |
| Drawn By   | RM                                       | Date Created | 02/09/21 | Scale | NOTED | at A3 |
| Contract No.   | 2020                                     |              |          |       |       |       |
| Contract Title   | 20:20 HOUSE                              |              |          |       |       |       |
| Drawing Title  | PH02 Recess 128 soffit details.          |              |          |       |       |       |
| Drawing No.  | 2020-PH02-DET-008                        |              |          |       | Rev   | C01   |