



ELE - PH-NORTH-01

- Denoted Siderise RH25-60/60 horizontal cavity barriers run continuously round building, typically 100mm above window openings.
- Denoted Siderise RV-90/60 cavity barrier with OSCI inserts to cladding panel depth.
- Denotes Rockwool TCB cavity barrier. To be installed from inside flats by others at every window and door. Barriers to extend 150mm past openings.
- Denoted Siderise RV-90/60 cavity barrier with OSCI inserts to cladding panel depth round wall vent ducting.

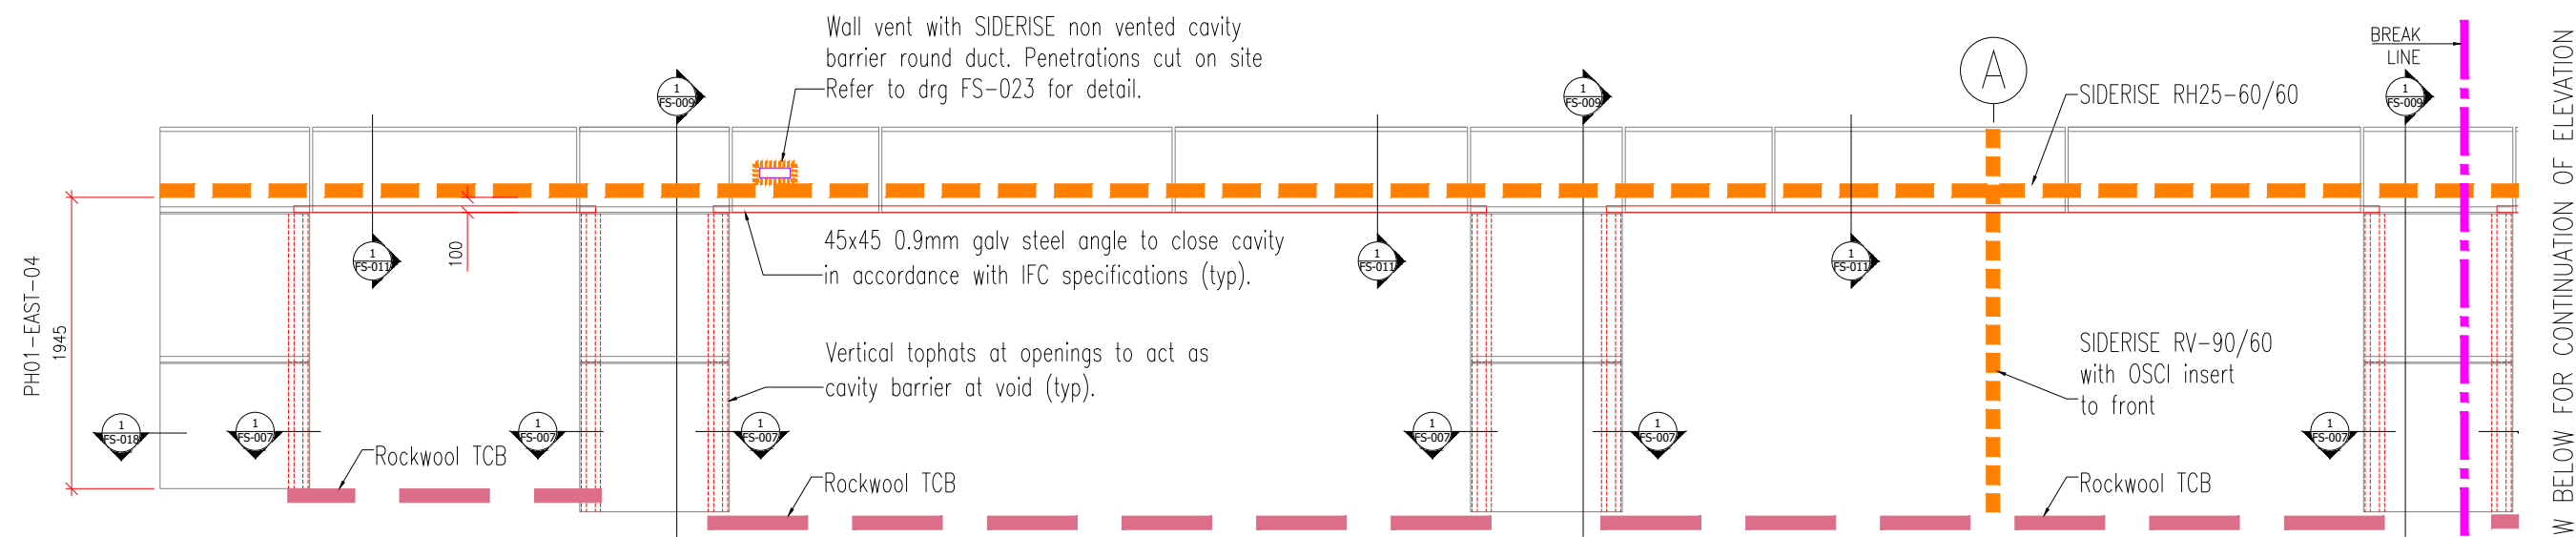

ELE - PH01-NORTH-02

SEE VIEW BELOW FOR CONTINUATION OF ELEVATION

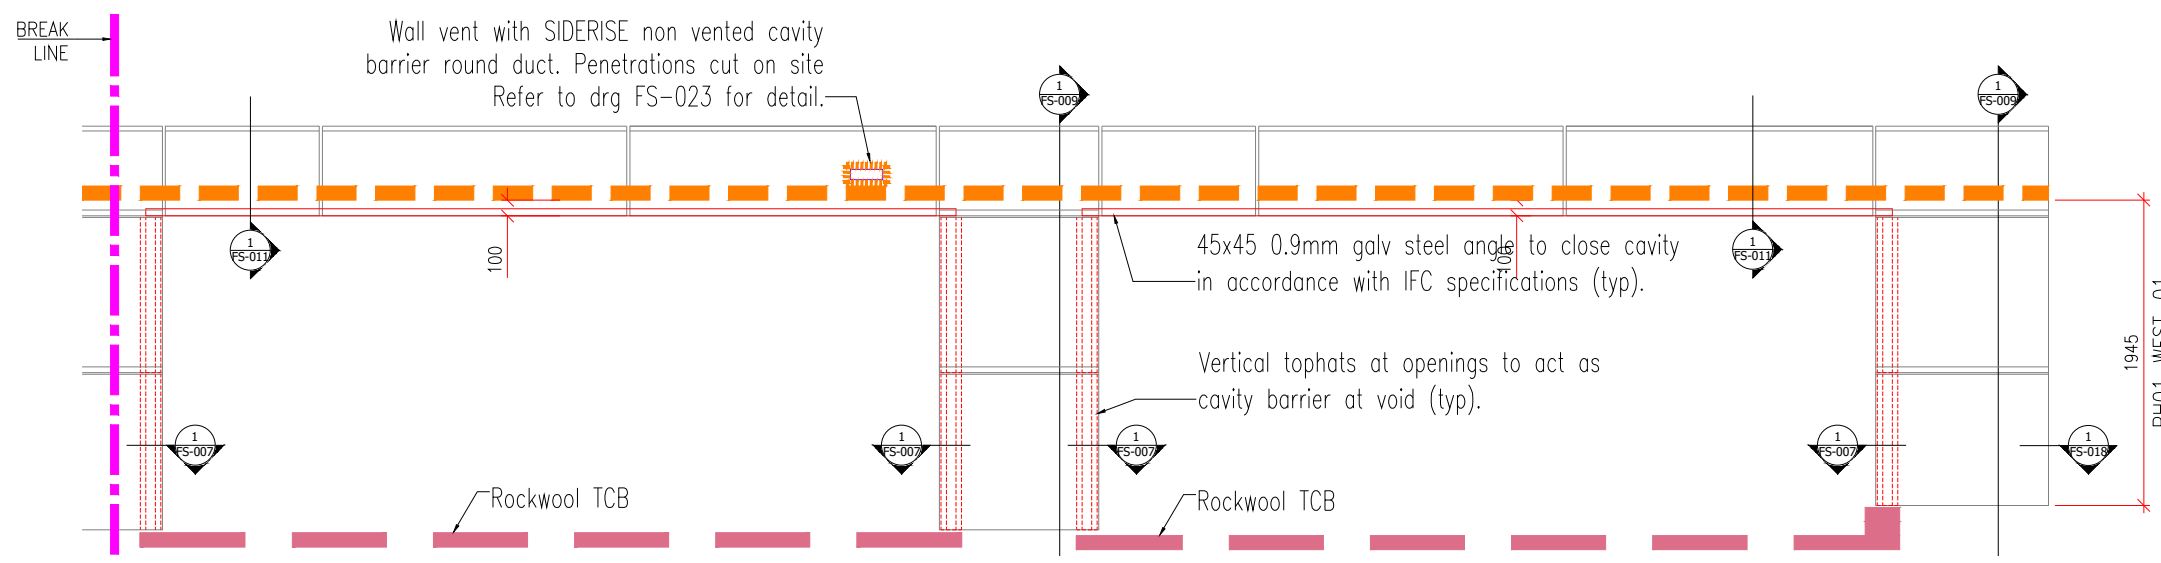

ELE - PH01-NORTH-02 (CONT')

CAVITY BARRIERS AND FIRE STRATEGY SUPPLIED AND INSTALLED IN ACCORDANCE WITH THE REQUIREMENTS OF IFC SPECIFICATIONS.

C02	UPDATED AS PER WINTech EMAIL 18/11/21	RM	18/11/21
C01	CONSTRUCTION ISSUE	RM	29/10/21
P06	UPDATED AS PER WINTech COMMENTS 02/07/21	RM	07/07/21
P05	UPDATED AS PER WINTech COMMENTS 17/06/21	RM	28/06/21
P04	GENERAL UPDATES	RM	22/06/21
P03	UPDATED AS PER WINTech COMMENTS 18/05/21	RM	28/05/21
P02	UPDATED AS PER WINTech COMMENTS 22/04/21	RM	03/05/21
P01	FIRST ISSUE	RM	21/04/21



**AJ Cladding LTD**  
Architectural Cladding Specialists

19A Wilson Street,  
Hamilton,  
ML3 0NH

+44 (0) 1698 339 104  
ajcladding.co.uk  
info@ajcladding.co.uk

Drawn By	RM	Date Created	20/04/21	Scale	1:50	at	A3
Contract No.	2020						
Contract Title	20:20 HOUSE						
Drawing Title	PENTHOUSE 01 NORTH ELEVATION CAVITY BARRIER LAYOUT						
Drawing No.	2020-PH01-FS-003					Rev	C02

AS BUILT 19/11/21