


AS BUILT 19/11/21

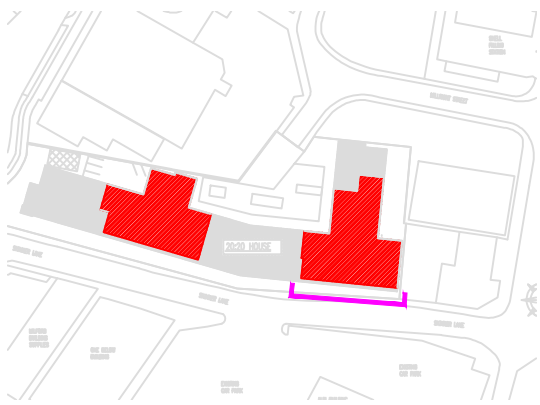


SITE KEY

NOTE:
IF THERE IS A GAP BETWEEN HEAD OF WINDOW / CURTAIN WALLING, REFER TO DETAIL 'DET-022'.

CAVITY BARRIERS AND FIRE STRATEGY SUPPLIED AND INSTALLED IN ACCORDANCE WITH THE REQUIREMENTS OF IFC SPECIFICATIONS.

- Denoted Siderise RH25-60/60 horizontal cavity barriers run continuously round building, typically 100mm above window openings.
- Denoted Siderise RV-90/60 cavity barrier with OSCI inserts to cladding panel depth.
- Denotes Rockwool TCB cavity barrier. To be installed from inside flats by others at every window and door. Barriers to extend 150mm past openings.
- Denoted Siderise non vented cavity barrier round wall vent ducting.

C01	IFC NOTE ADDED - CONSTRUCTION ISSUE	RM	28/10/21
P07	UPDATED AS PER WINTech COMMENTS 08/10/21	RM	14/10/21
P06	UPDATED AS PER WINTech COMMENTS 30/09/21	RM	01/10/21
P05	UPDATED AS PER WINTech COMMENTS 16/09/21	RM	23/09/21
P04	DETAIL REFS ADDED	RM	14/9/21
P03	GENERAL UPDATES.	RM	22/06/21
P02	GENERAL UPDATES.	RM	17/06/21
P01	FIRST ISSUE	RM	19/05/21
Rev	Description	By	Date
 <p>AJ Cladding LTD Architectural Cladding Specialists</p> <p>19A Wilson Street, Hamilton, ML3 0NH</p> <p>+44 (0) 1698 339 104 ajcladding.co.uk info@ajcladding.co.uk</p>			
Drawn By	RM	Date Created	19/05/21
Contract No.	2020	Scale	1:50 at A3
Contract Title	20: 20 HOUSE		
Drawing Title	PENTHOUSE 02 NORTH ELEVATION CAVITY BARRIER LAYOUT		
Drawing No.	2020-PH02-FS-003	Rev	C01