



DESIGNED AND INSTALLED AS PER FASTFRAME DESIGN CALCULATIONS. PLEASE REFER TO FILES; -
'FASTFRAME CALCULATIONS V7 [AB-19-03-21].PDF'
'2020 BUILDING V2 - 202191020 [AB-19-03-21].PDF'
'GENIUS-PRIME-R18122 PRIME TEST DATA (3).PDF'

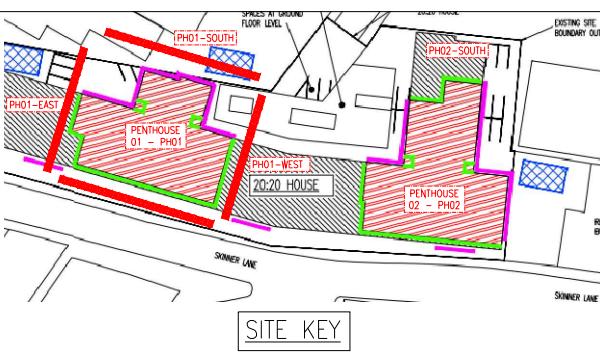

PH01-EAST-04

ELE - PH-NORTH-01

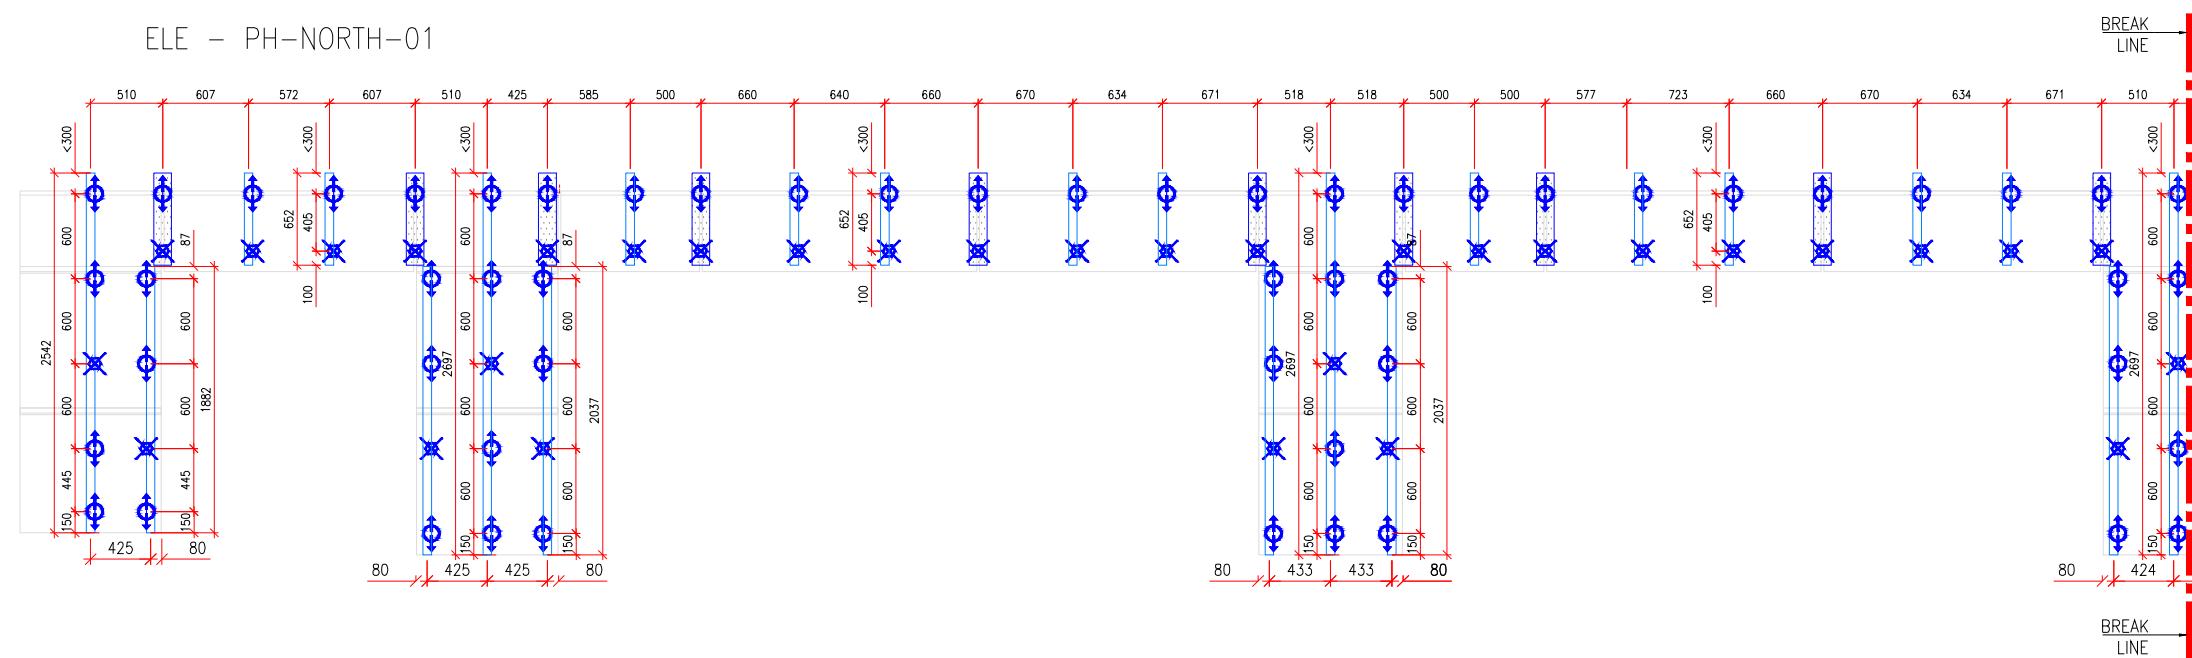

SEE VIEW BELOW FOR CONTINUATION OF ELEVATION.

(FOR FIXING INSTALLATION REFER TO FASTERFRAME INSTALLATION GUIDE)

<u>LOCATION</u>	<u>FIXING</u>
BRACKET TO RAIL	PCF/44/4.8x19
GENIUS BLOCK TO RAIL	5.5x38 LOW PROFILE TEK SCREW
BRACKET TO METAL FIX	PCF/33/5.5x55 W15


C02	UPDATED AS PER WINTECH EMAIL	18/11/21	RM	18/11/21
C01	CONSTRUCTION ISSUE		RM	28/10/21
P06	UPDATED AS PER WINTECH COMMENTS	02/07/21	RM	07/07/21
P05	GENERAL UPDATES		RM	24/06/21
P04	UPDATED TO NEW SITE DIMS		SA	22/03/21
P03	UPDATED TO NEW SITE DIMS		SA	16/03/21
P02	PRINT UPDATED		SA	26/01/21
P01	FIRST ISSUE		SA	24/01/21

AJ Cladding LTD
Architectural Cladding Specialists

By Date
19A Wilson Street,
Hamilton,
ML3 0NH

+44 (0) 1698 339 104
ajcladding.co.uk

ELE - PH01-NORTH-02

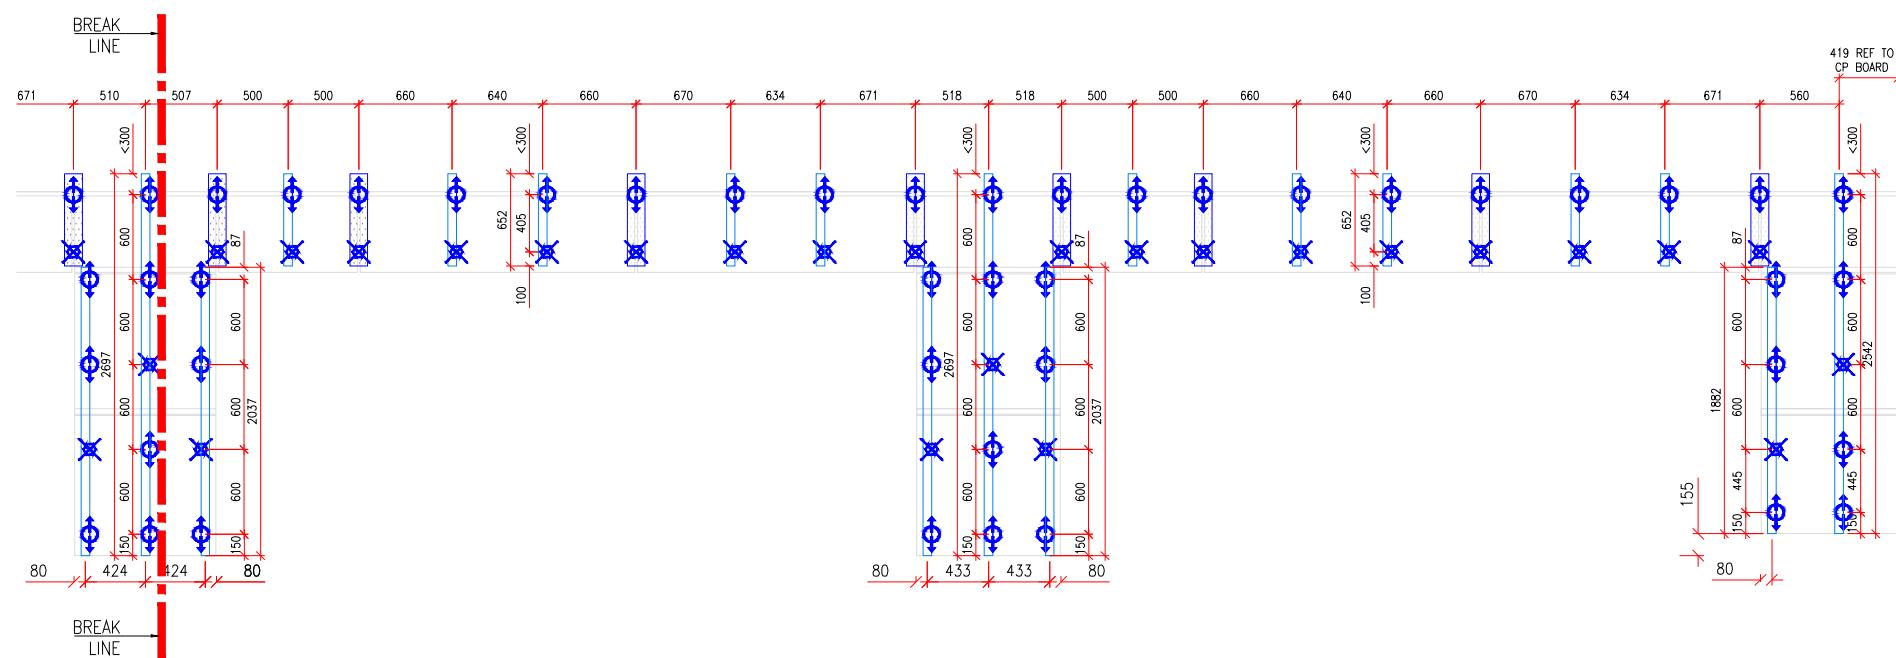

ELE - PH01-NORTH-02 (CONT')

AS BUILT 19/11/21