
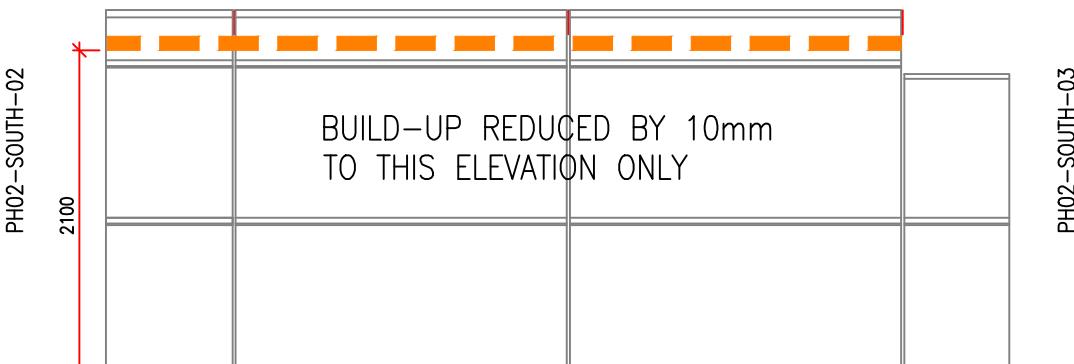
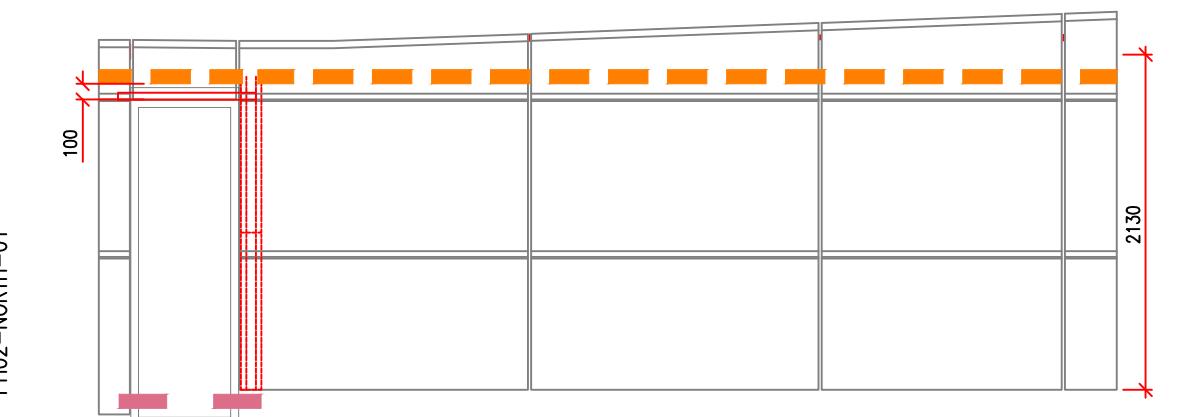





CAVITY BARRIERS AND FIRE STRATEGY
SUPPLIED AND INSTALLED IN
ACCORDANCE WITH THE REQUIREMENTS
OF IFC SPECIFICATIONS.

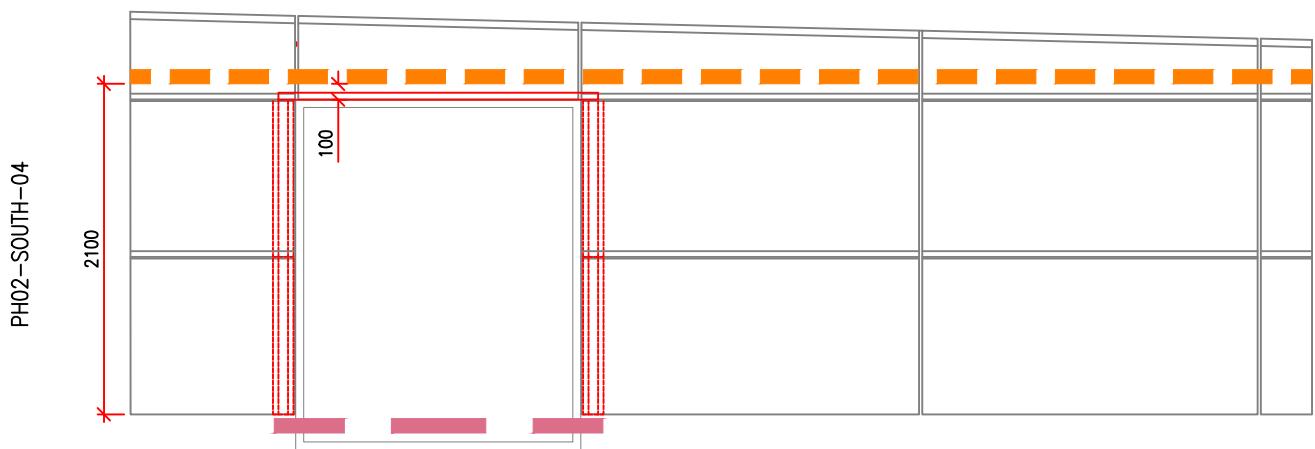

PH02-SOUTH-03

PH02-EAST-02

2099

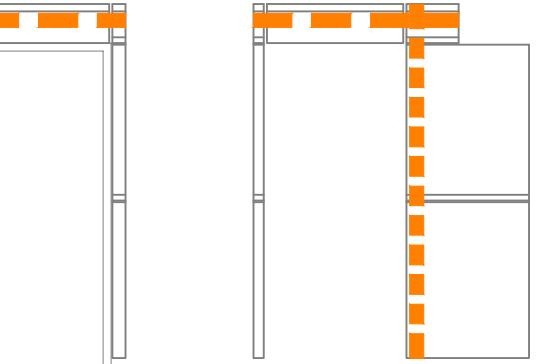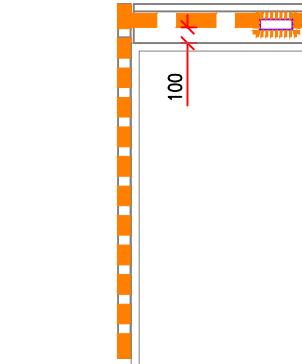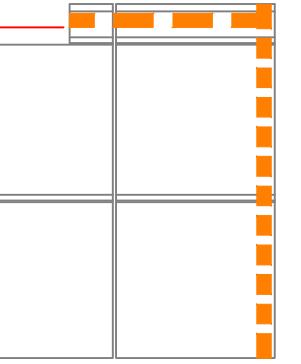

C01	IFC NOTE ADDED - CONSTRUCTION ISSUE	RM	28/10/21
P06	UPDATED AS PER WINTECH COMMENTS 08/10/21	RM	14/10/21
P05	UPDATED AS PER WINTECH COMMENTS 30/09/21	RM	01/10/21
P04	UPDATED AS PER WINTECH COMMENTS 16/09/21	RM	23/09/21
P03	DETAIL REFS ADDED	RM	14/9/21
P02	GENERAL UPDATES.	RM	17/06/21
P01	FIRST ISSUE	RM	18/05/21
Rev	Description	By	Date

19A Wilson Street,
Hamilton,
ML3 0NH

+44 (0) 1698 339 104
ajcladding.co.uk
info@ajcladding.co.uk

Drawn By RM Date Created 18/05/21 Scale 1:50 at A3

Contract No. 2020

Contract Title 20:20 HOUSE

Drawing Title PENTHOUSE 02 EAST ELEVATION
CAVITY BARRIER LAYOUT

Drawing No. 2020-PH02-FS-006 Rev C01

PH02 APT 124
RECESSED BALCONY

AS BUILT 19/11/21