







ELE - PH01-WEST-01

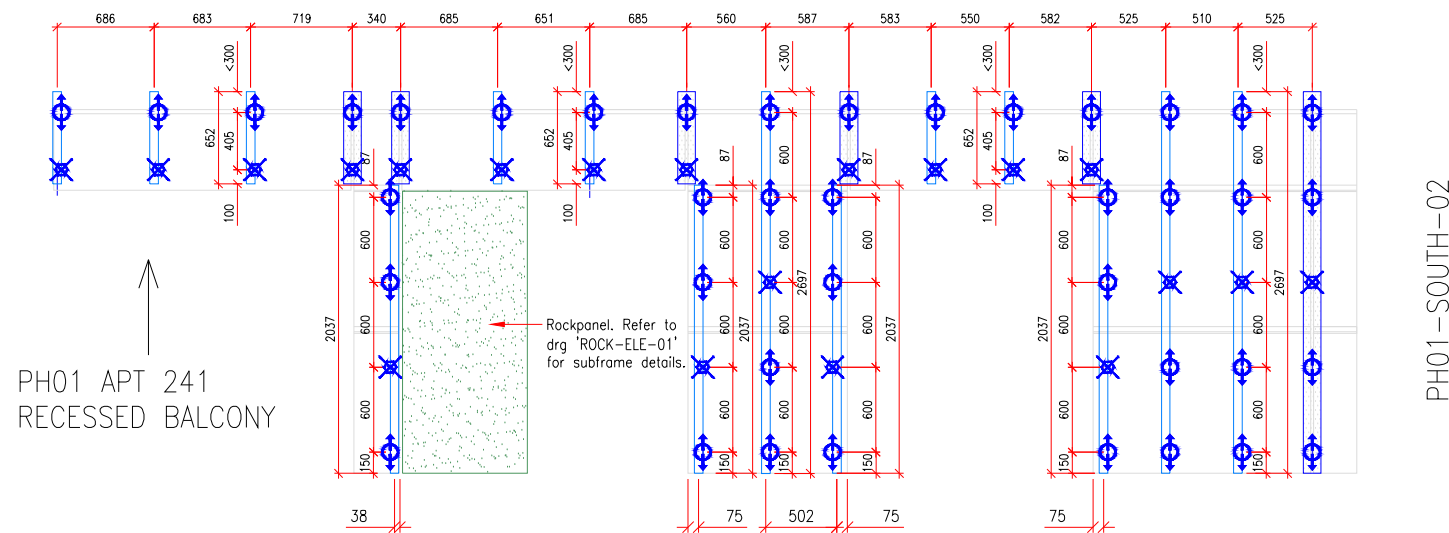

DESIGNED AND INSTALLED AS PER FASTFRAME DESIGN
CALCULATIONS. PLEASE REFER TO FILES; -
'FASTFRAME CALCULATIONS V7 [AB-19-03-21].PDF'
'2020 BUILDING V2 - 202191020 [AB-19-03-21].PDF'
'GENIUS-PRIME-R18122 PRIME TEST DATA (3).PDF'


-  - 60x40 ALU ANGLE - FIX/ANG/HD/60/40 - 2.2
-  - 125x60 ALU T - FIX/TEE/HD/125/60 - 2.2
-  - FLOATING BRACKET - FF/FIX/BR/50
-  - SINGLE DEAD FIX BRACKET - FF/FIX/BR/50
-  - DOUBLE DEAD FIX BRACKET - FF/FIX/BRD/50

(FOR FIXING INSTALLATION REFER TO FASTFRAME INSTALLATION GUIDE)

<u>LOCATION</u>	<u>FIXING</u>
BRACKET TO RAIL	PCF/44/4.8x19
GENIUS BLOCK TO RAIL	5.5x38 LOW PROFILE TEK SCREW
BRACKET TO METAL FIX	PCF/33/5.5x55 W15

C02	UPDATED AS PER WINTECH EMAIL 18/11/21	RM	18/11/21
C01	CONSTRUCTION ISSUE	RM	28/10/21
P06	UPDATED AS PER WINTECH COMMENTS 02/07/21	RM	07/07/21
P05	GENERAL UPDATES	RM	24/06/21
P04	UPDATED TO NEW RECESSED BALCONY SITE DIMS	SA	06/05/21
P03	UPDATED TO NEW SITE DIMS	SA	16/03/21
P02	PRINT UPDATED	SA	26/01/21
P01	FIRST ISSUE	SA	24/01/21
Rev	Description	By	Date

AS BUILT 19/11/21

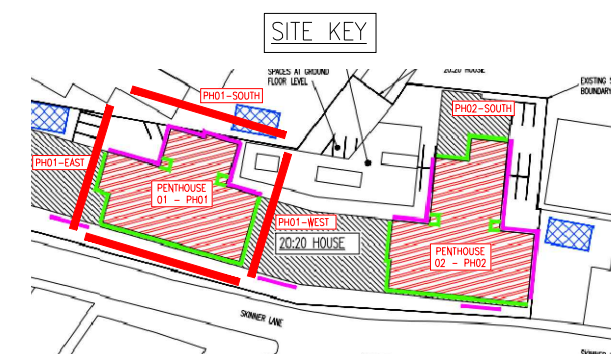

AJ Cladding LTD
Architectural Cladding Specialists

19A Wilson Street,
Hamilton,
ML3 0NH
+44 (0) 1698 339 104
ajcladding.co.uk
info@ajcladding.co.uk

Drawn By	SA	Date Created	04.01.20	Scale	NTS	of A1
Contract No.	2020					
Contract Title	20:20 HOUSE					
Drawing Title	PENTHOUSE 01 WEST ELEVATION BRACKET SETOUTS 01					
Drawing No.	2020-PH01-WES-BKT-001			Rev	C02	