


PH02-EAST-03


ELE - PH-NORTH-01

PH02-EAST-04

CHANNEL SET-OUT DIFFERS HERE DUE TO SHORTED BASE CLADDING PANEL.

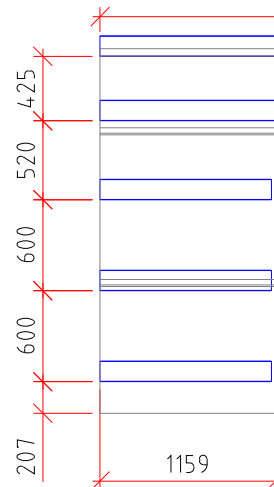

ELE - PH-NORTH-02

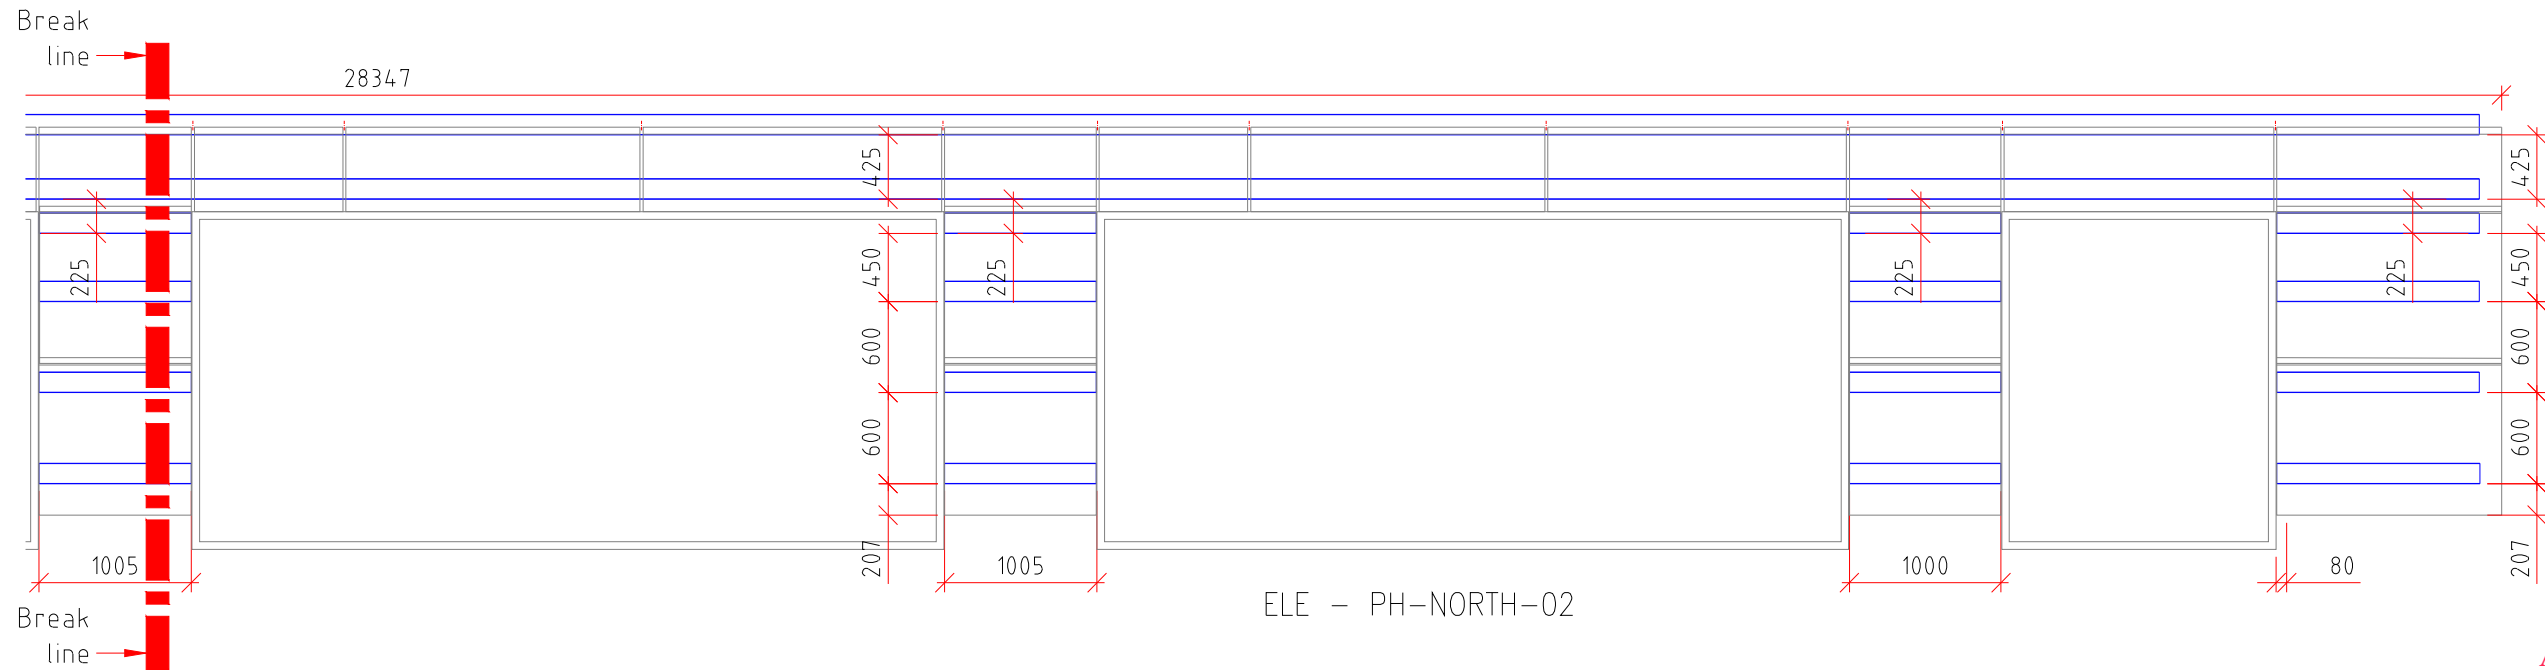

Break line


Break line

PH02-WEST-01



DESIGNED AND INSTALLED AS PER FASTFRAME DESIGN CALCULATIONS. PLEASE REFER TO FILES; -
'2020 HOUSE - PENTHOUSE NO. 2 - STEEL - VERTICAL FACADE - 90MM - GENIUS PRIME - 202041021_V1.PDF'
'2020 BUILDING - RECESS BALCONIES - STEEL - VERTICAL FACADE - 90MM - GENIUS PRIME - 202041021_V1.PDF'

AS BUILT 19/11/21

C01	CONSTRUCTION ISSUE	RM	28/10/21
P04	UPDATED AS PER WINTTECH COMMENTS 16/09/21	RM	23/09/21
P03	SET-OUT HEIGHTS REVISED.	RM	26/08/21
P02	SET-OUT HEIGHTS REVISED.	RM	09/08/21
P01	FIRST ISSUE	RM	09/07/21
Rev	Description	By	Date
<div><div>AJ Cladding LTD Architectural Cladding Specialists</div><div>19A Wilson Street, Hamilton, ML3 0NH +44 (0) 1698 339 104 ajcladding.co.uk info@ajcladding.co.uk</div></div>			
Drawn By	RM	Date Created	09/07/21
Contract No.	2020	Scale	1:50
Contract Title	20: 20 HOUSE	ot	A3
Drawing Title	PENTHOUSE 02 NORTH ELEVATION GALV CHANNEL SETOUT 01		
Drawing No.	2020-PH02-CH-001	Rev	C01