




ELE - PH02-EAST-02

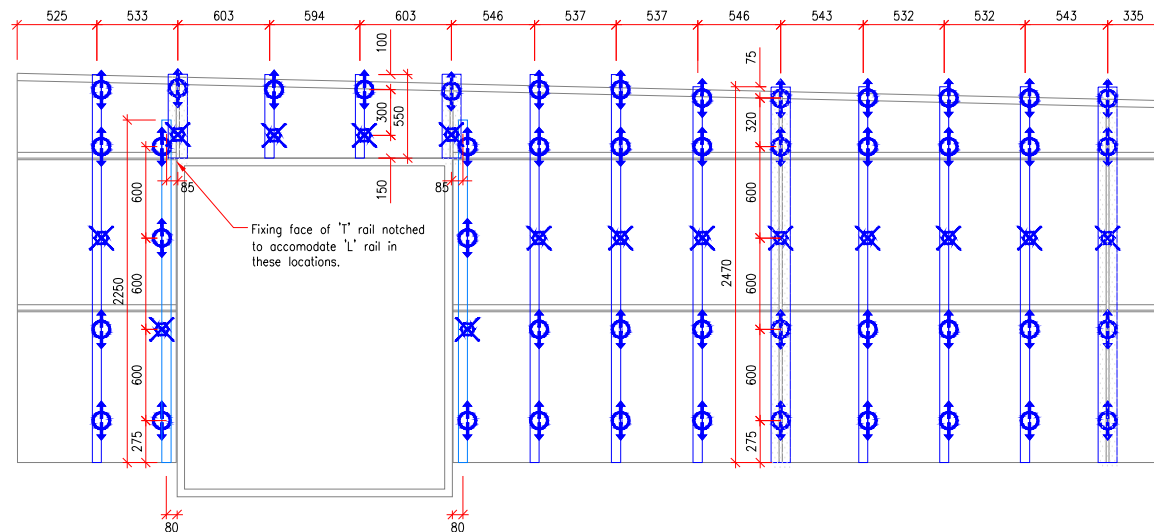


ELE - PH02-EAST-03

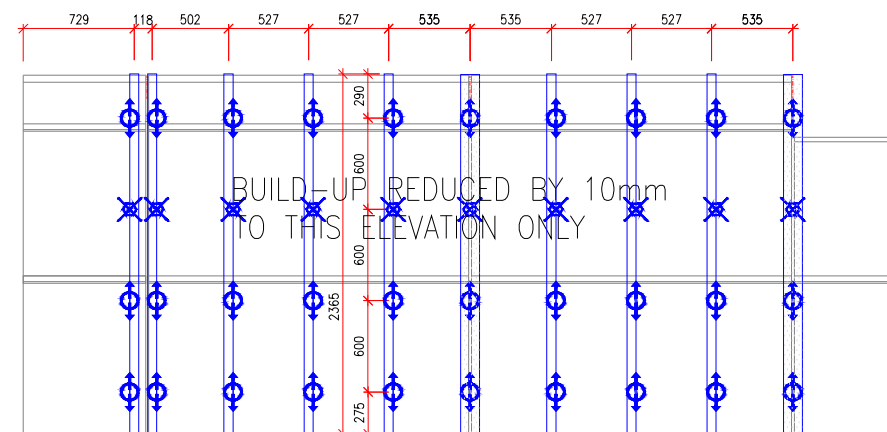



ELE - PH02-EAST-01

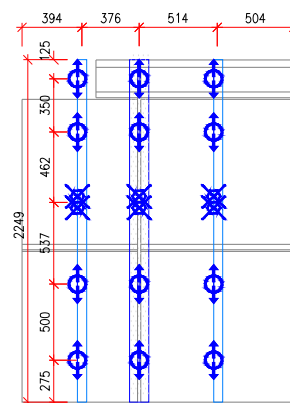

PH02-SOUTH-03

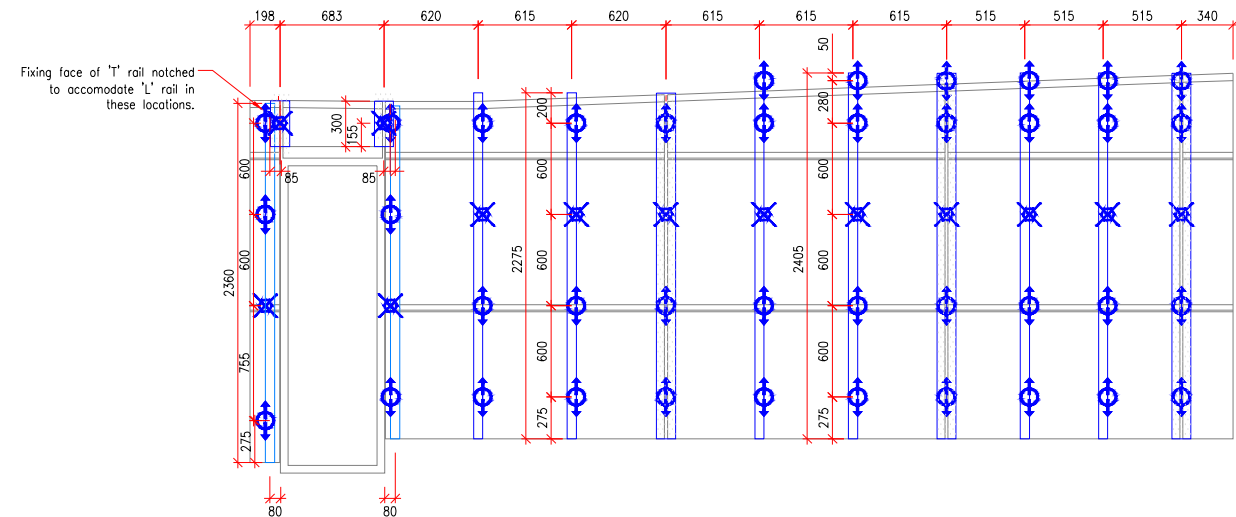

ELE - PH02-EAST-04

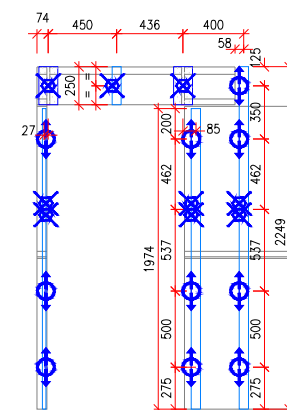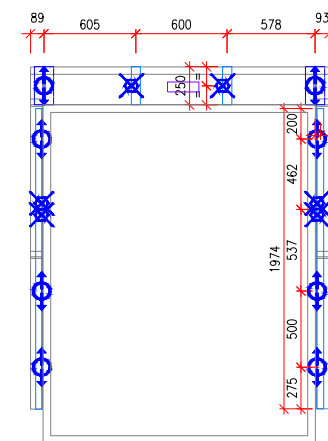

AS BUILT 19/11/21

C01	CONSTRUCTION ISSUE	RM	28/10/21
P10	UPDATED AS PER WINTech COMMENTS 08/10/21	RM	14/10/21
P09	RAIL CENTRES REVISED (SEE REV CLOUDS)	RM	30/09/21
P08	E03 RAIL CENTRES CORRECTED.	RM	28/09/21
P07	RAIL HEIGHTS REVISED.	RM	23/09/21
P06	SET-OUTS REVISED.	RM	03/09/21
P05	SET-OUT HEIGHTS REVISED.	RM	26/08/21

Rev	Description	By	Date
-----	-------------	----	------



**AJ Cladding LTD**  
Architectural Cladding Specialists

19A Wilson Street,  
Hamilton,  
ML3 0NH

+44 (0) 1698 339 104  
ajcladding.co.uk  
info@ajcladding.co.uk

Drawn By	SA	Date Created	04/01/21	Scale	1:50	at A3
----------	----	--------------	----------	-------	------	-------






Contract No.	2020
--------------	------

Contract Title	20:20 HOUSE
----------------	-------------

Drawing Title	PENTHOUSE 02 EAST ELEVATION
---------------	-----------------------------

BRACKET SETOUTS OF			
Drawing No.	2020-PH02-EAS-BKT-001	Rev.	001

DESIGNED AND INSTALLED AS PER FASTFRAME DESIGN CALCULATIONS. PLEASE REFER TO FILES; -  
'2020 HOUSE - PENTHOUSE NO. 2 - STEEL - VERTICAL FACADE - 90MM - GENIUS PRIME - 202041021\_V1.PDF'  
'2020 BUILDING - RECESS BALCONIES - STEEL - VERTICAL FACADE - 90MM - GENIUS PRIME - 202041021\_V1.PDF'

-  - 60x40 ALU ANGLE - FIX/ANG/HD/60/40 - 2.2
-  - 125x60 ALU T - FIX/TEE/HD/125/60 - 2.2
-  - FLOATING BRACKET - FF/FIX/BR/50
-  - SINGLE DEAD FIX BRACKET - FF/FIX/BR/50
-  - DOUBLE DEAD FIX BRACKET - FF/FIX/BRD/50

(FOR FIXING INSTALLATION REFER TO FASTFRAME INSTALLATION GUIDE)

LOCATION	FIXING
BRACKET TO RAIL	PCF/44/4.8x19
GENIUS BLOCK TO RAIL	5.5x38 LOW PROFILE TEK SCREW
BRACKET TO METAL FIX	PCF/33/5.5x55 W15