



Detail 1 – East Elevation

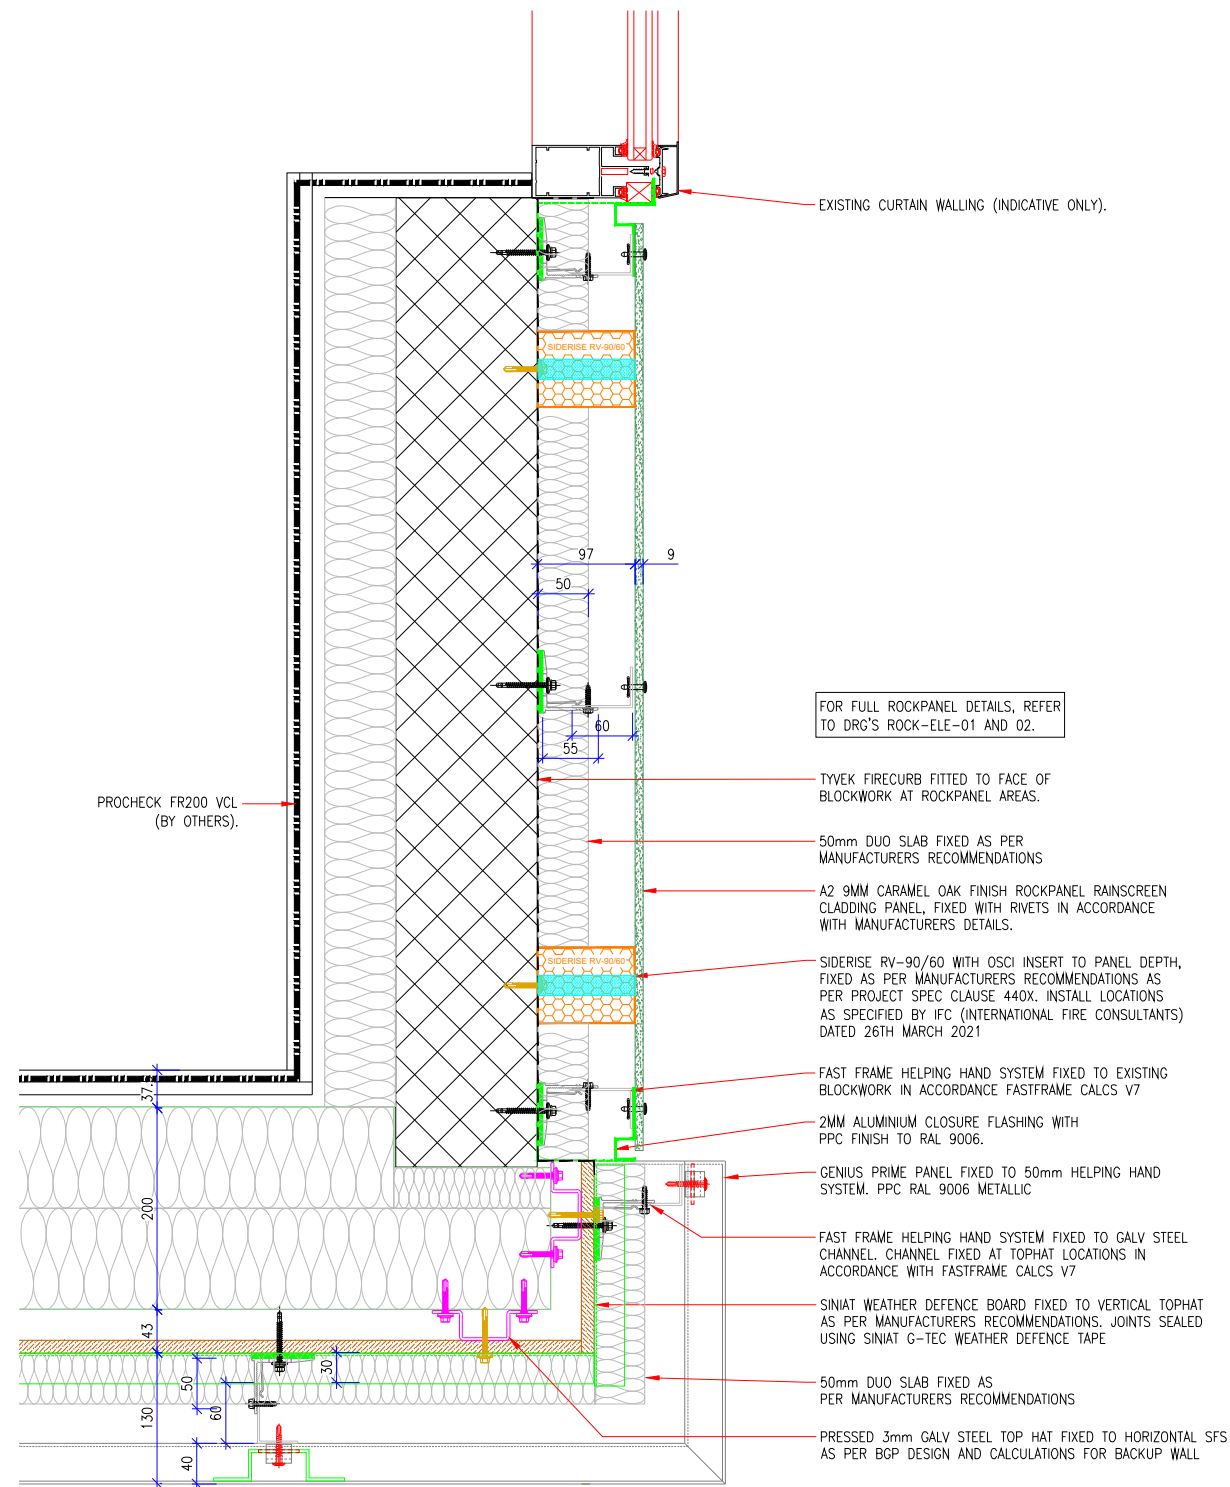

Detail 2 – West Elevation

AS BUILT 19/11/21

C01	CONSTRUCTION ISSUE	RM	29/10/21
P05	UPDATED AS PER WINTECH COMMENTS 09/07/21	RM	27/07/21
P04	UPDATED AS PER WINTECH COMMENTS 02/07/21	RM	07/07/21
P03	UPDATED AS PER WINTECH COMMENTS 17/06/21	RM	28/06/21
P02	UPDATED AS PER WINTECH COMMENTS 18/05/21	RM	28/05/21
P01	FIRST ISSUE	RM	15/05/21
Rev	Description	By	Date
<div><div><div><div><b>AJ Cladding LTD</b></div><div>Architectural Cladding Specialists</div></div><div><div>19A Wilson Street, Hamilton, ML3 0NH</div><div>+44 (0) 1698 339 104 ajcladding.co.uk info@ajcladding.co.uk</div></div></div></div>			
Drawn By	RM	Date Created	15/05/21
Contract No.	2020		
Contract Title	20:20 HOUSE		
Drawing Title	FIRE STRATEGY GENIUS TO ROCKPANEL VERTICAL DETAIL		
Drawing No.	2020-PH01-FS-013		C01