



Section on 'A-A'  
(SCALE 1:10 @ A3)

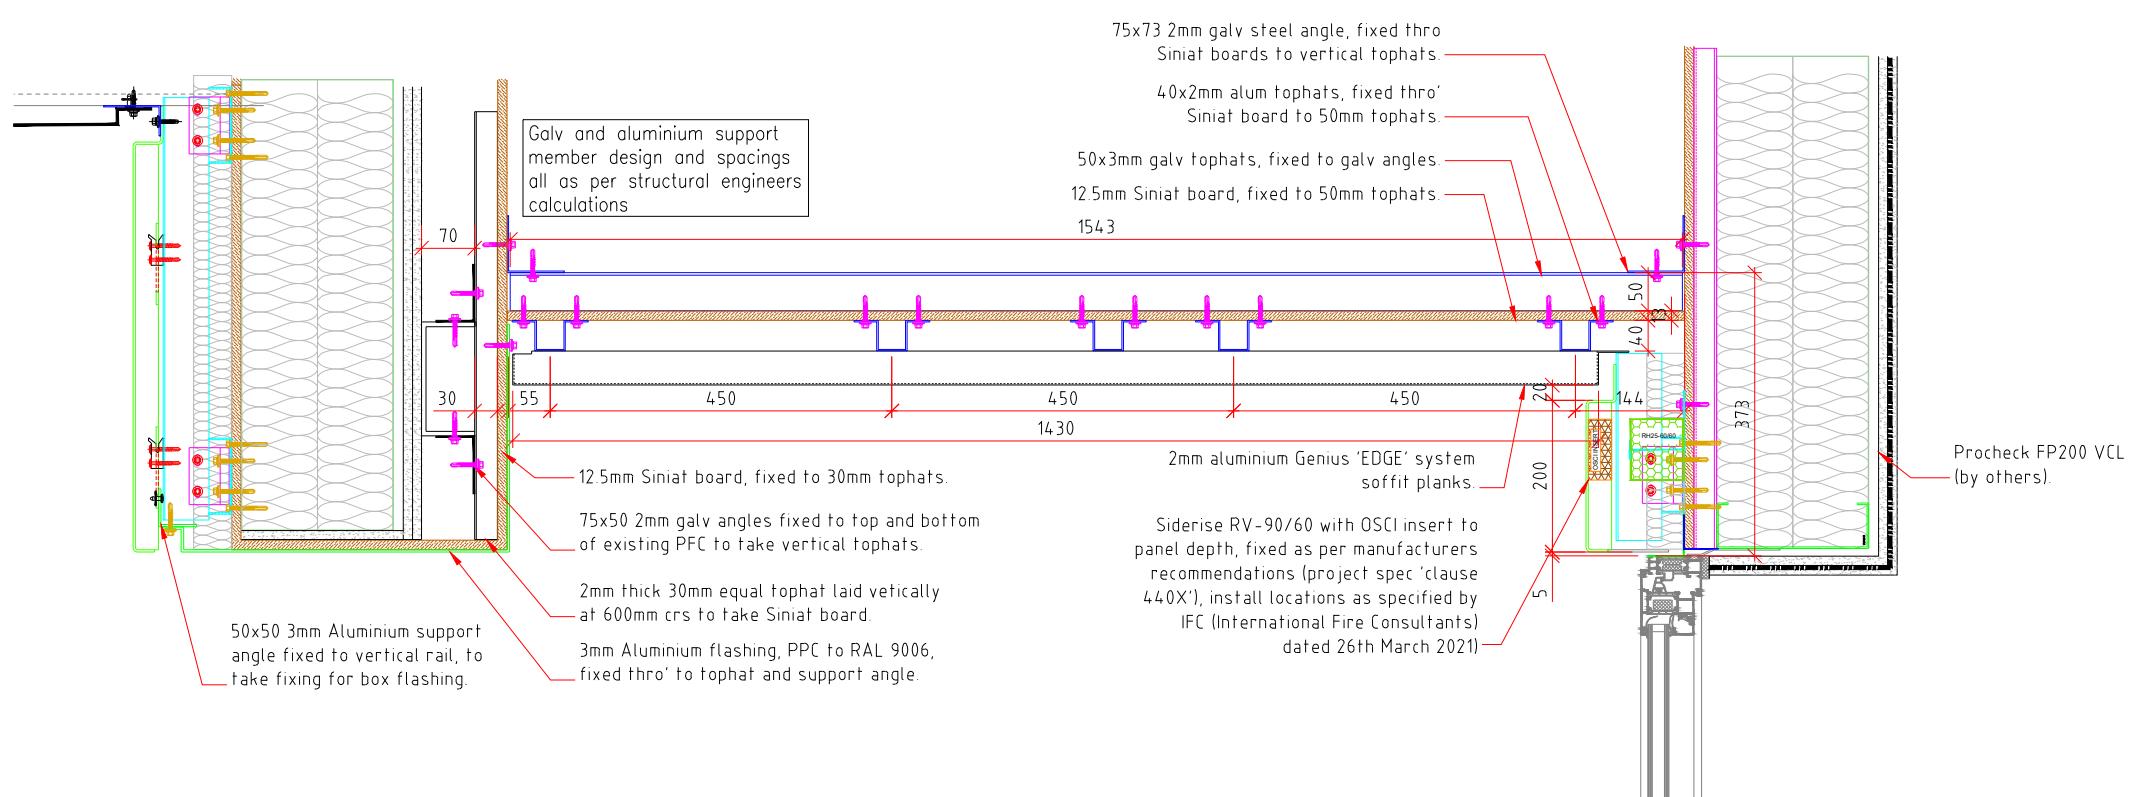

Section on 'B-B'  
(SCALE 1:10 @ A3)

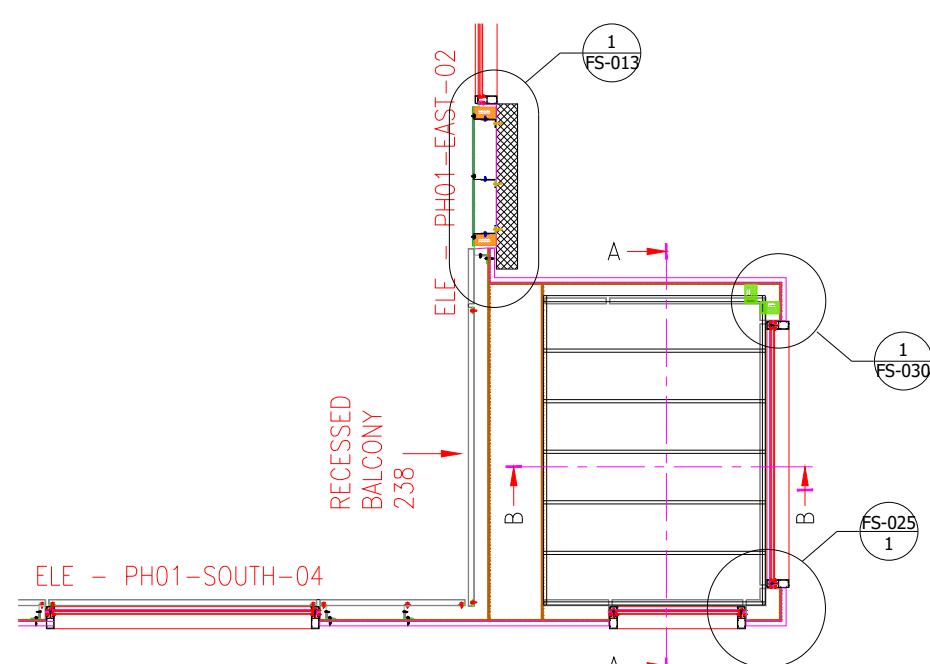

Key Plan  
(SCALE 1:50 @ A3)

AS BUILT 19/11/21

C01	CONSTRUCTION ISSUE	RM	29/10/21
P05	UPDATED AS PER WINTECH COMMENTS 05/08/21	RM	06/08/21
P04	UPDATED AS PER WINTECH COMMENTS 09/07/21	RM	27/07/21
P03	UPDATED AS PER WINTECH COMMENTS 02/07/21	RM	07/07/21
P02	UPDATED AS PER WINTECH COMMENTS 17/06/21	RM	28/06/21
P01	FIRST ISSUE	RM	26/05/21
Rev	Description	By	Date



19A Wilson Street,  
Hamilton,  
ML3 0NH

+44 (0) 1698 339 104

ajcladding.co.uk

info@ajcladding.co.uk

Drawn By	RM	Date Created	26/05/21	Scale	1:5	at A3
Contract No.	2020					
Contract Title	20: 20 HOUSE					
Drawing Title	PH01 Recess 238 soffit details.					
Drawing No.	2020-PH01-FS-015	Rev	C01			