




ELE - PH-NORTH-01

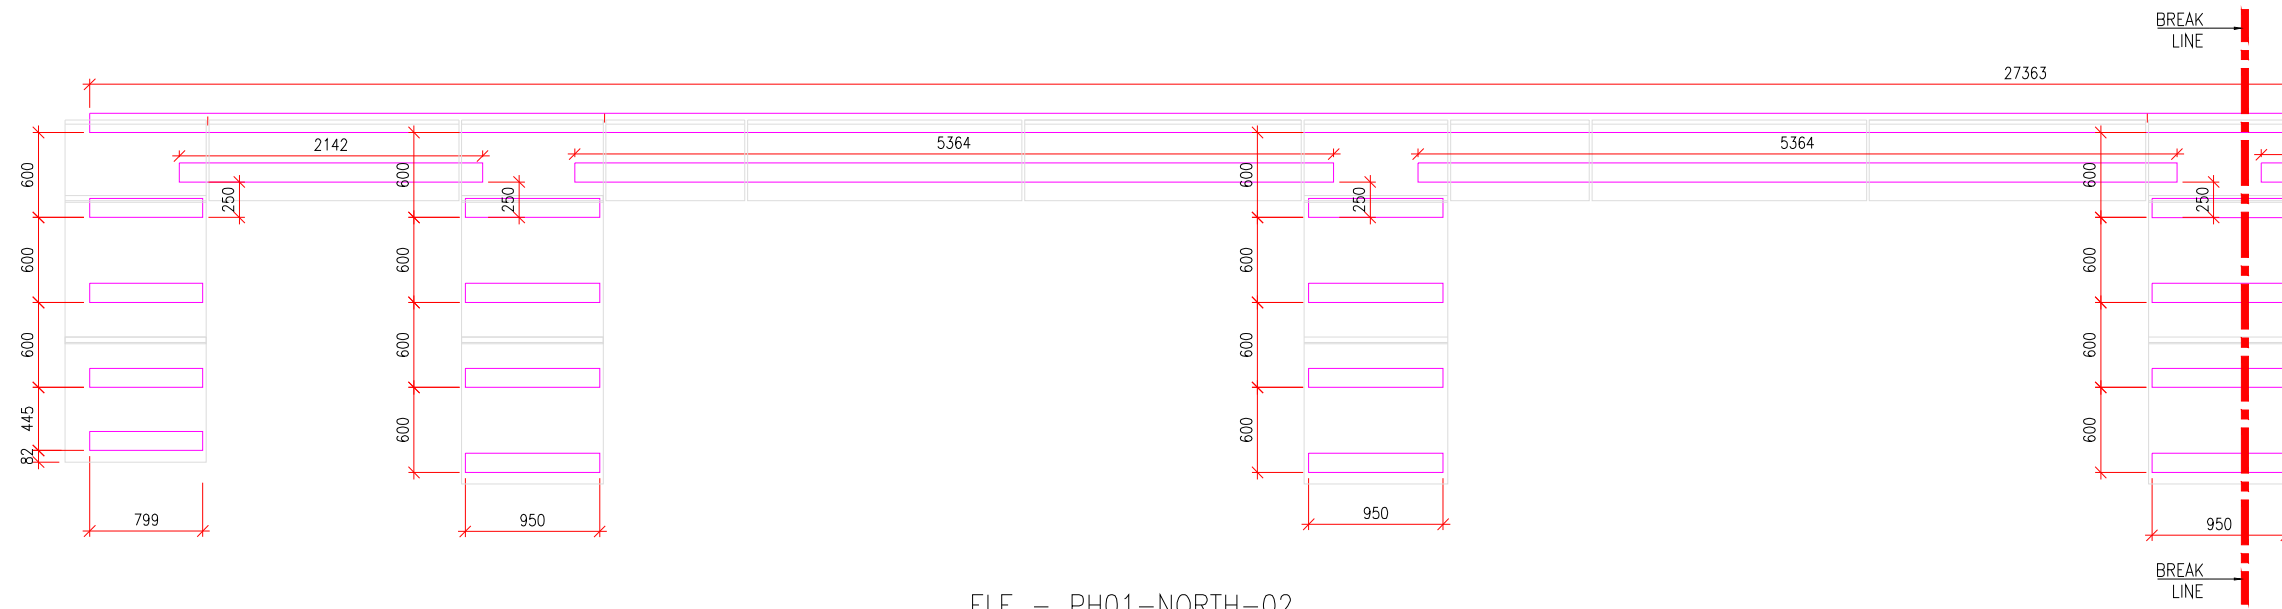

ELE - PH01-NORTH-02

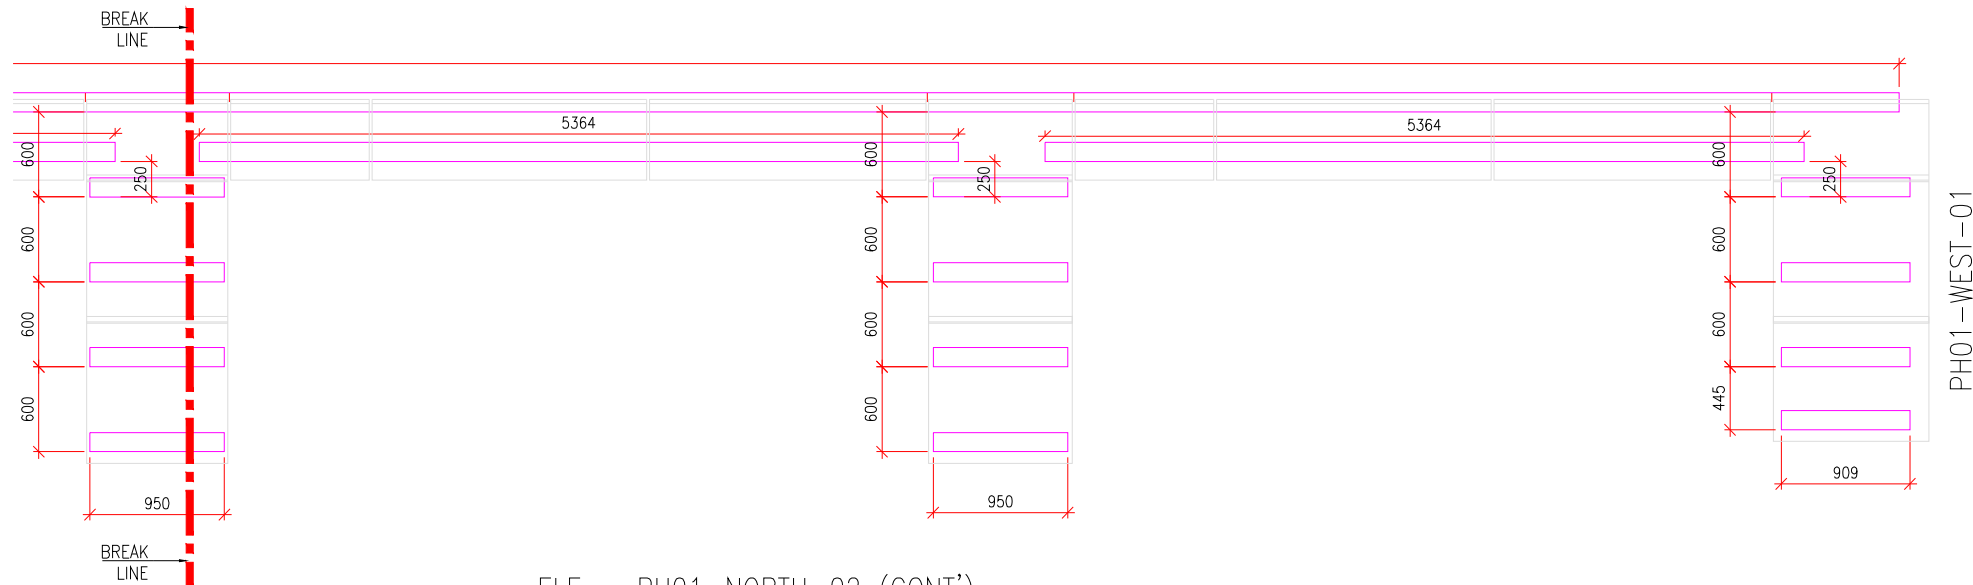


ELE - PH01-NORTH-02 (CONT')

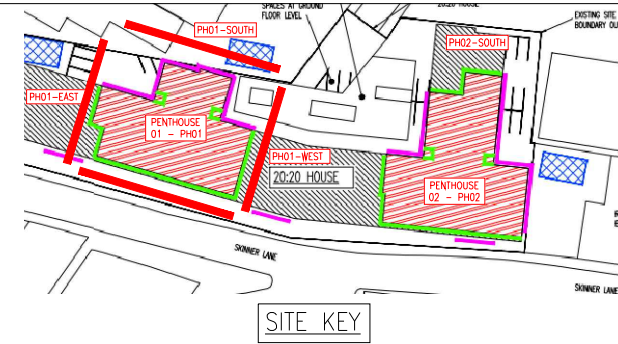

SEE VIEW BELOW FOR ELEVATION CONTINUATION

NOTES

-  SUPPORT TRAY 02 (T02) – 135 TRAY
-  SUPPORT TRAY 01 (T01) – 210 TRAY

C02	UPDATED AS PER WINTECH EMAIL 18/11/21		RM	18/11/21		
C01	CONSTRUCTION ISSUE		RM	29/10/21		
P03	UPDATED AS PER WINTECH COMMENTS		RM	24.09.21		
P02	TRAY CTRS AMENDED TO V7 CALCS		SA	09.03.21		
Rev	Description		By	Date		
			19A Wilson Street, Hamilton, ML3 0NH			
			+44 (0) 1698 339 104 ajcladding.co.uk info@ajcladding.co.uk			
AJ Cladding LTD Architectural Cladding Specialists						
Drawn By	SA	Date Created	04.01.20	Scale	NTS	ot A1
Contract No.	2020					
Contract Title	20:20 HOUSE					
Drawing Title	PENTHOUSE 01 NORTH ELEVATION SUPPORT TRAY SETOUTS 01					
Drawing No.	2020-PH01-NOR-BKT-002			Rev	C02	

AS BUILT 19/11/21