



Detail 1 – Section on 'A-A'

(SCALE 1:10 @ A3)

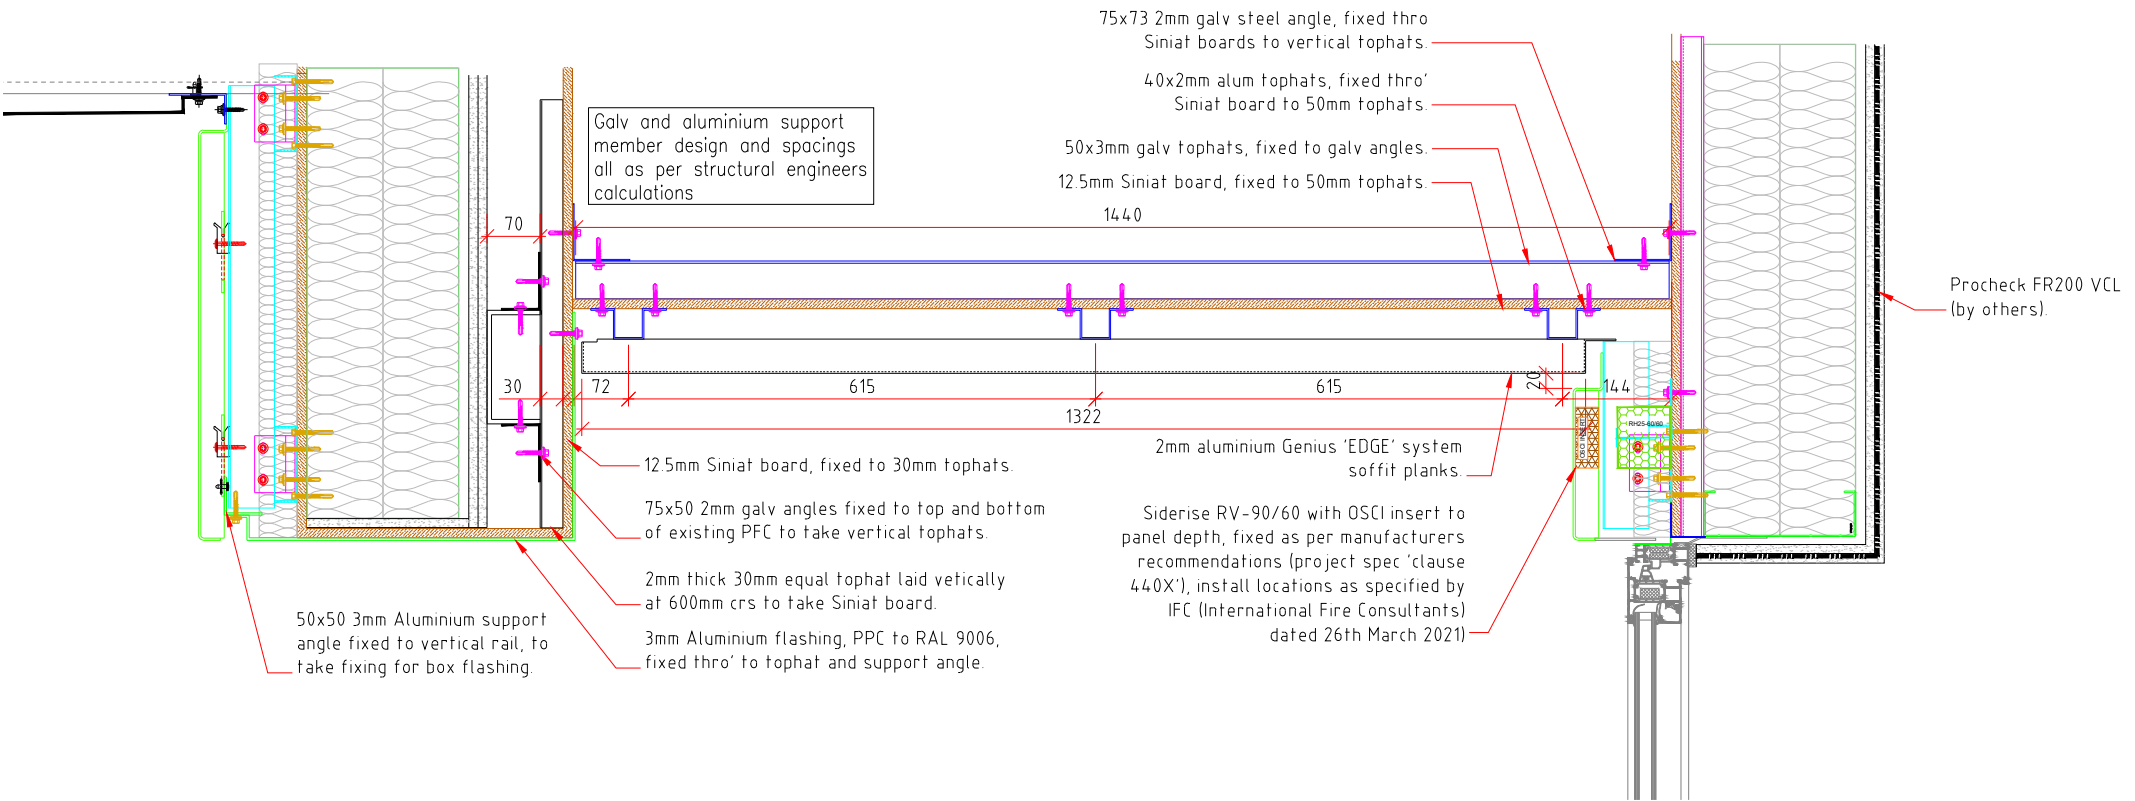

Detail 2 – Section on 'B-B'


(SCALE 1:10 @ A3)

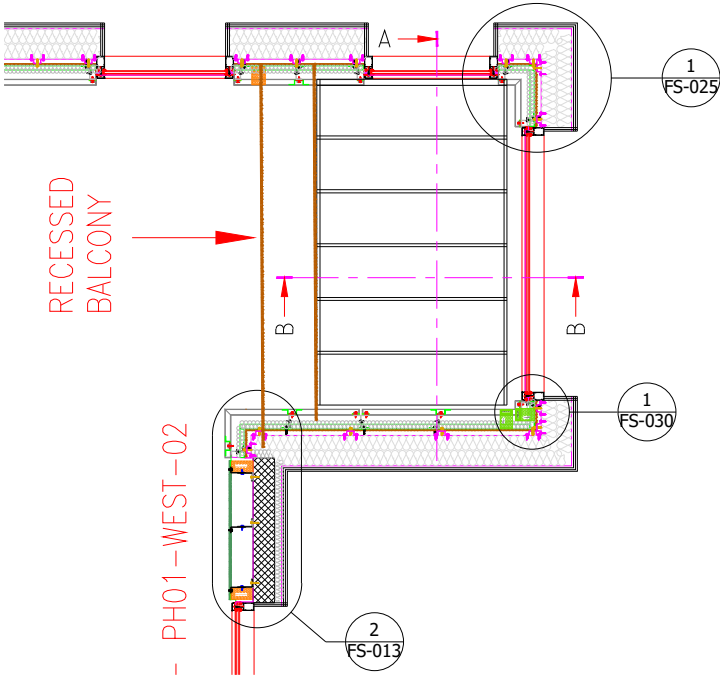

Key Plan

(SCALE 1:50 @ A3)

AS BUILT 19/11/21

C01	CONSTRUCTION ISSUE	RM	29/10/21
P05	UPDATED AS PER WINTECH COMMENTS 05/08/21	RM	06/08/21
P04	UPDATED AS PER WINTECH COMMENTS 09/07/21	RM	29/07/21
P03	UPDATED AS PER WINTECH COMMENTS 02/07/21	RM	07/07/21
P02	UPDATED AS PER WINTECH COMMENTS 17/06/21	RM	28/06/21
P01	FIRST ISSUE	RM	26/05/21
Rev	Description	By	Date
<div><div><div><div><b>AJ Cladding LTD</b></div><div>Architectural Cladding Specialists</div></div></div><div><div>19A Wilson Street, Hamilton, ML3 0NH</div><div>+44 (0) 1698 339 104 ajcladding.co.uk info@ajcladding.co.uk</div></div></div>			
Drawn By	RM	Date Created	26/05/21 Scale 1:5 ot A3
Contract No.	2020		
Contract Title	20:20 HOUSE		
Drawing Title	PH01 Recess 241 soffit details.		
Drawing No.	2020-PH01-FS-016	Rev	C01