



ELE - PH-WEST-01

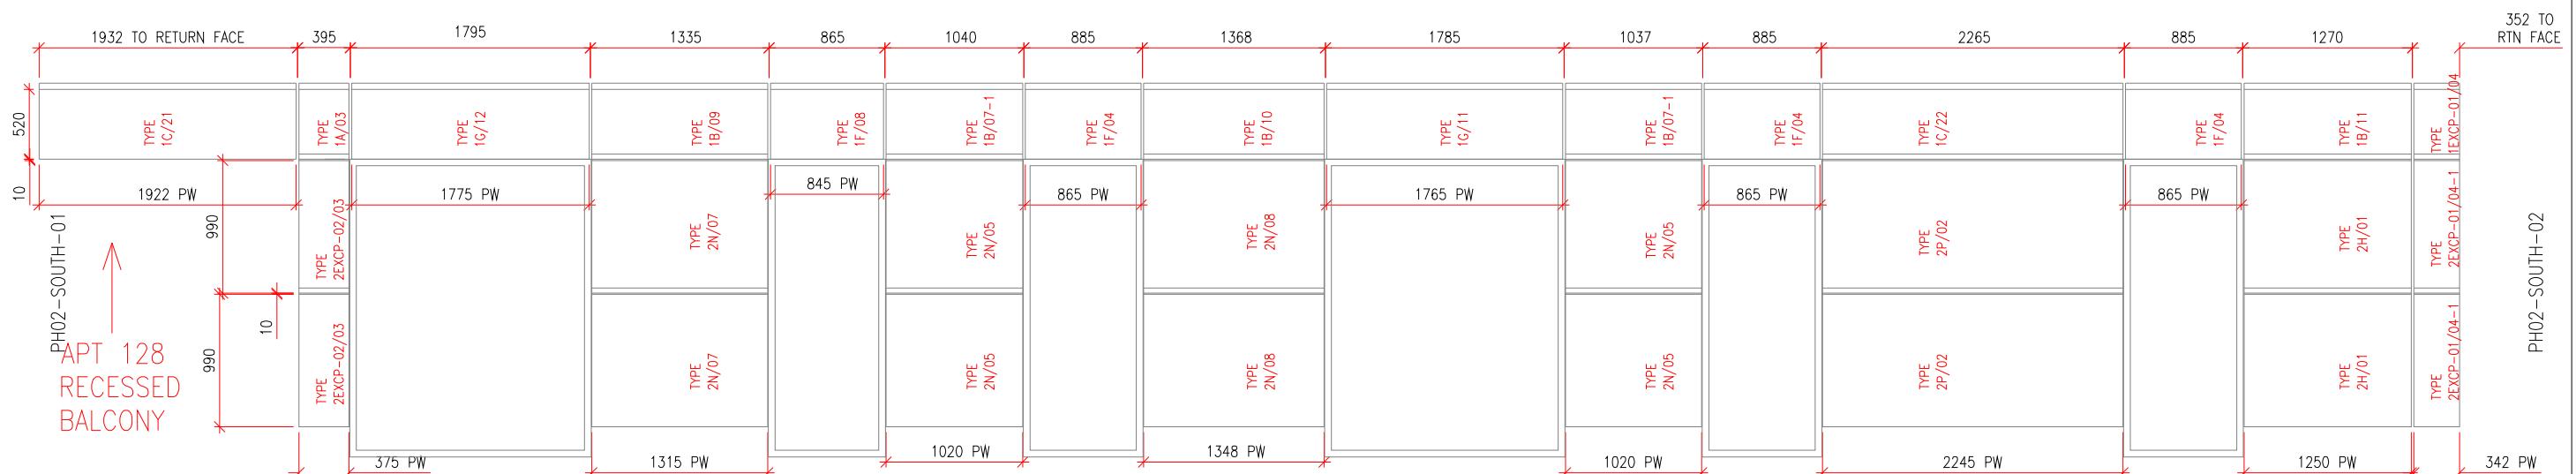

ELE - PH-WEST-02

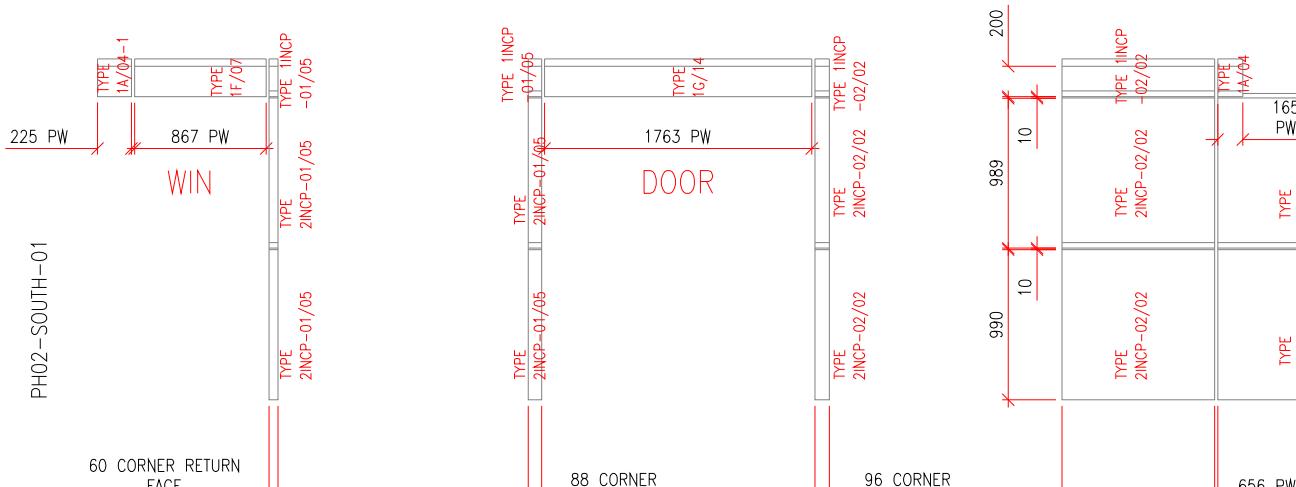

PH02 APT 128
RECESSED BALCONY

AS BUILT 19/11/21

C01	CONSTRUCTION ISSUE	RM	28/10/21
P04	PANEL HEIGHTS REVISED	RM	09/09/21
P03	GENERAL UPDATES	RM	03/09/21
P02	PANEL REFS ADDED	SA	22/01/21
P01	FIRST ISSUE	SA	05/01/21
Rev	Description	By	Date



AJ Cladding LTD

info@ajcladding.co.uk

04 / 01 / 21

04/01/21 Scale 1:50 at

Contract No.	2020		
Contract Title	20: 20 HOUSE		
Drawing Title	PENTHOUSE 02 WEST ELEVATION CLADDING SETOUTS 02		
Drawing No.	2020-PH02-ELE-002	Rev	C01