




ELE - PH02-EAST-02

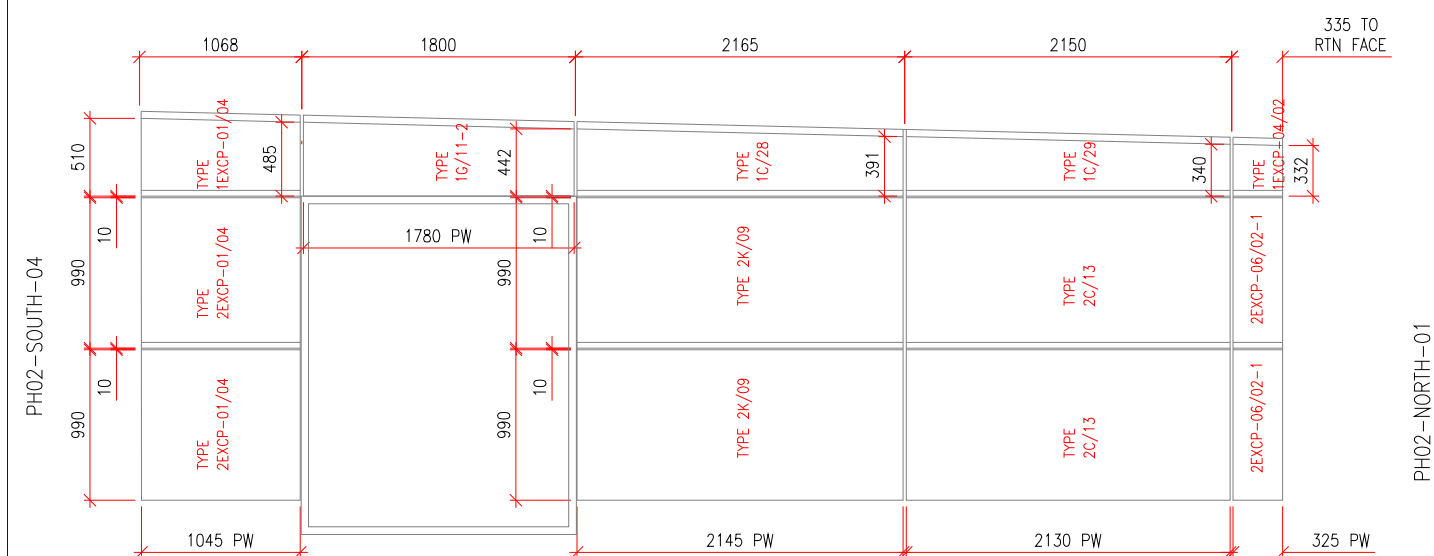



ELE - PH02-EAST-03

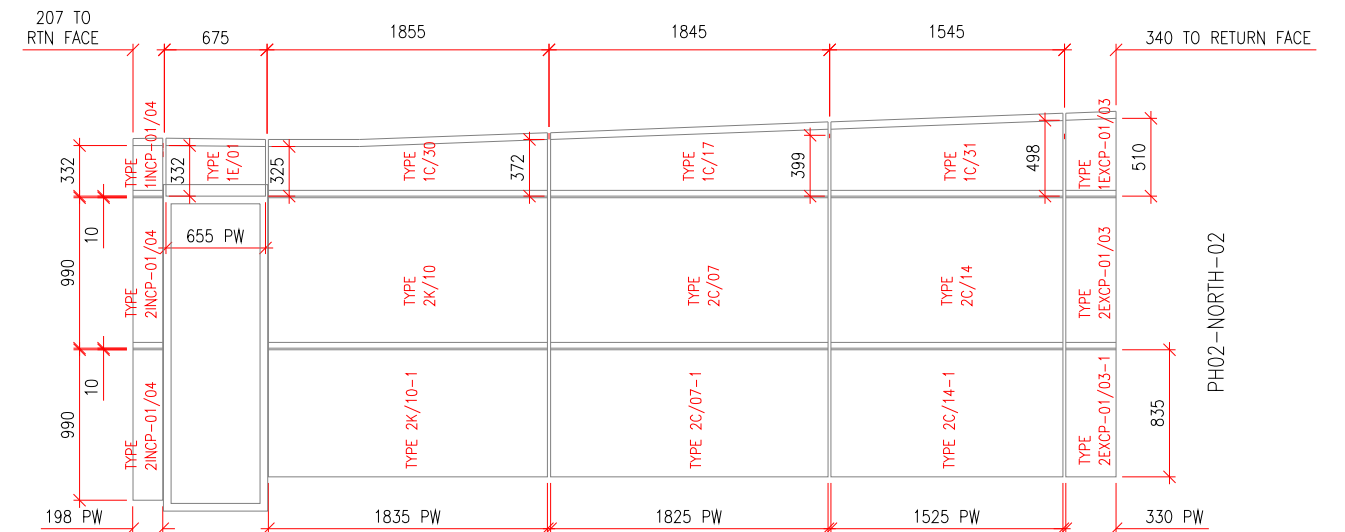

ELE - PH02-EAST-04

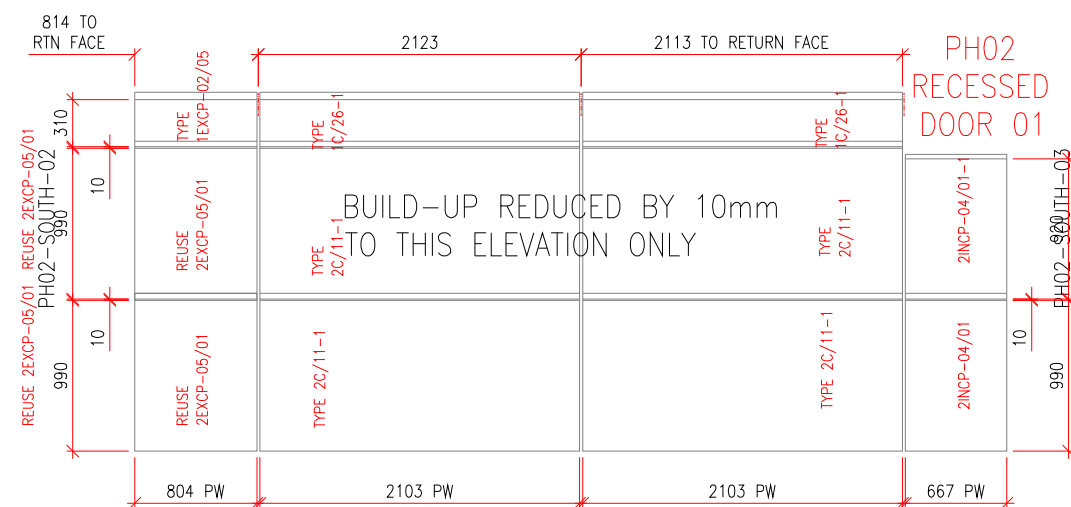

ELE - PH02-EAST-01

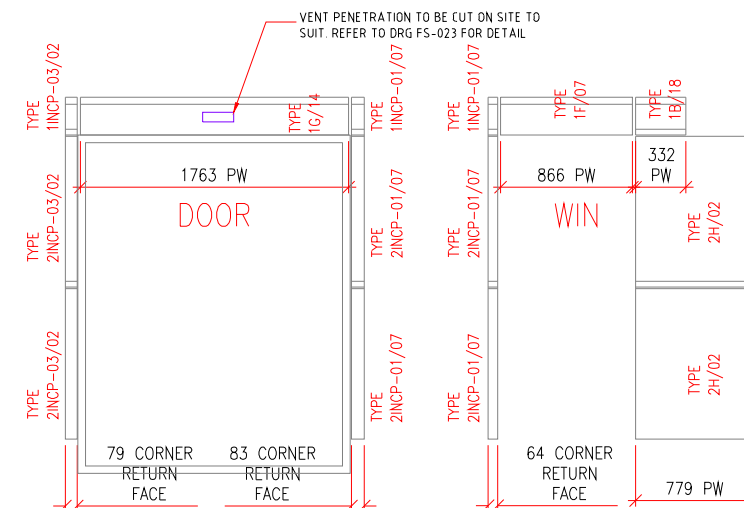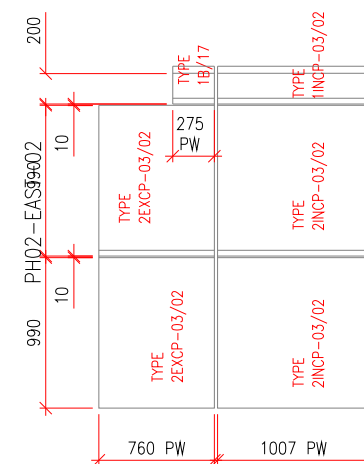


PH02 APT 124
RECESSED BALCONY

AS BUILT 19/11/21

C01	CONSTRUCTION ISSUE	RM	28/10/21
P04	PANEL HEIGHTS REVISED	RM	09/09/21
P03	GENERAL UPDATES	RM	03/09/21
P02	PANEL REFS ADDED	SA	22/01/21
P01	FIRST ISSUE	SA	05/01/21

Rev	Description	By	Date



AJ Cladding LTD
Architectural Cladding Specialists

19A Wilson Street,
Hamilton,
ML3 0NH

+44 (0) 1698 339 104
ajcladding.co.uk
info@ajcladding.co.uk

Drawn By	SA	Date Created	04/01/21	Scale	1:50	ot A3
Contract No.	2020					
Contract Title	20: 20 HOUSE					
Drawing Title	PENTHOUSE 02 EAST ELEVATION CLADDING SETOUTS 04					
Drawing No.	2020-PH02-ELE-004			Rev	C01	