




PH02-NORTH-02

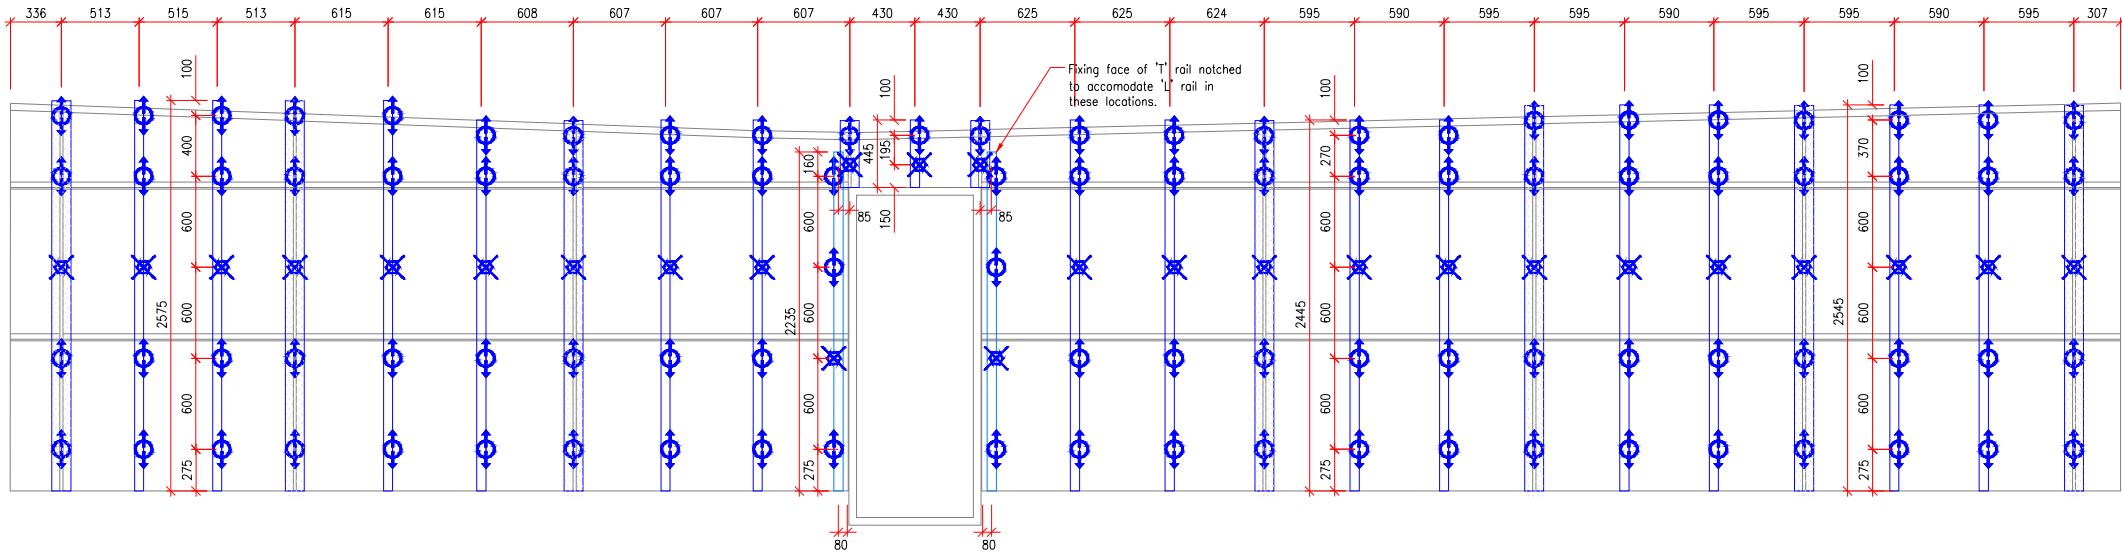

PH02-SOUTH-01

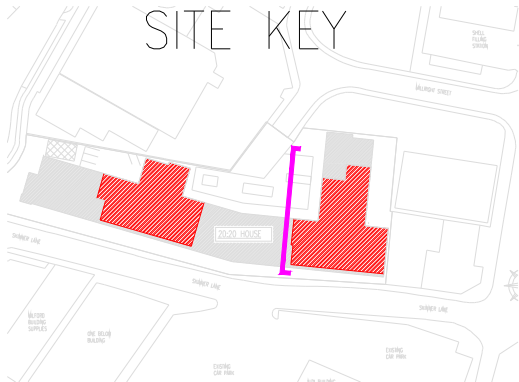



ELE - PH-WEST-01

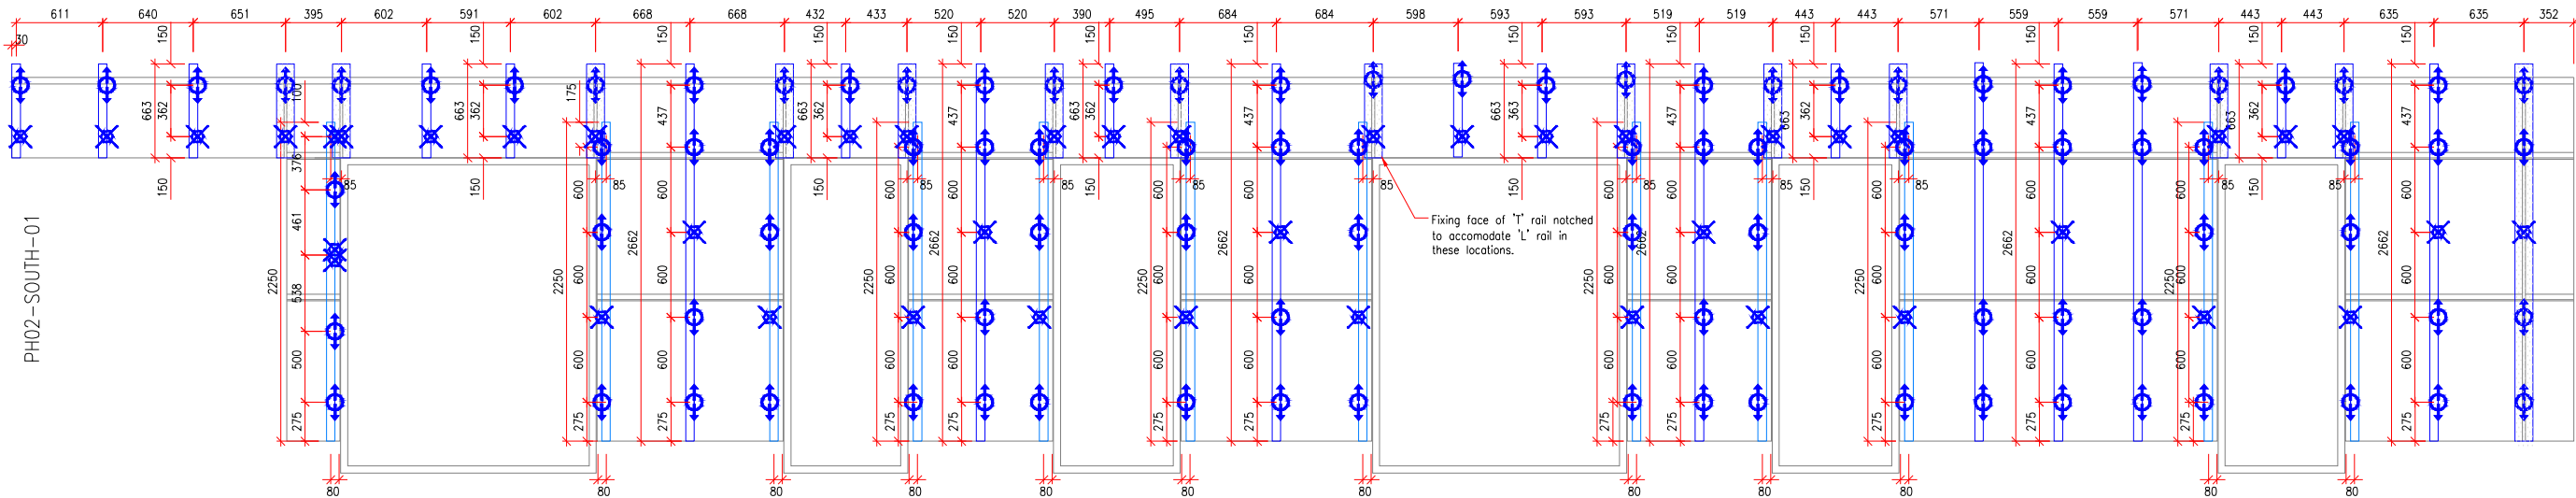


ELE - PH-WEST-02

AS BUILT 19/11/21

PH02-SOUTH-01

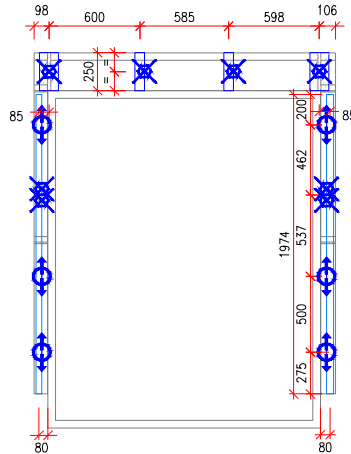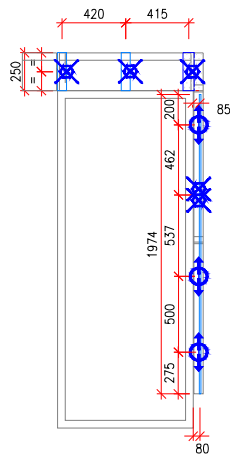

PH02-WEST-02

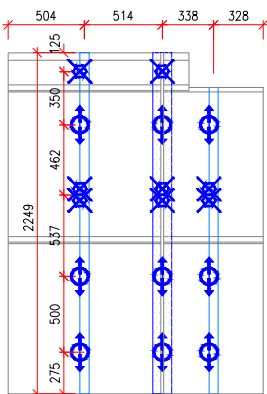

DESIGNED AND INSTALLED AS PER FASTFRAME DESIGN CALCULATIONS. PLEASE REFER TO FILES; -
'2020 HOUSE - PENTHOUSE NO. 2 - STEEL - VERTICAL FACADE - 90MM - GENIUS PRIME - 202041021_V1.PDF'
'2020 BUILDING - RECESS BALCONIES - STEEL - VERTICAL FACADE - 90MM - GENIUS PRIME - 202041021_V1.PDF'

- 60x40 ALU ANGLE - FIX/ANG/HD/60/40 - 2.2
- 125x60 ALU T - FIX/TEE/HD/125/60 - 2.2
- FLOATING BRACKET - FF/FIX/BR/50
- SINGLE DEAD FIX BRACKET - FF/FIX/BR/50
- DOUBLE DEAD FIX BRACKET - FF/FIX/BRD/50

(FOR FIXING INSTALLATION REFER TO FASTFRAME INSTALLATION GUIDE)

LOCATION	FIXING
BRACKET TO RAIL	PCF/44/4.8x19
GENIUS BLOCK TO RAIL	5.5x38 LOW PROFILE TEK SCREW
BRACKET TO METAL FIX	PCF/33/5.5x55 W15

C01	CONSTRUCTION ISSUE	RM	28/10/21
P09	BRACKETS ADJUSTED (SEE REV CLOUD).	RM	14/10/21
P08	UPDATED AS PER WINTech COMMENTS 30/09/21	RM	01/10/21
P07	RAIL HEIGHTS REVISED	RM	23/09/21
P06	SET-OUTS REVISED.	RM	03/09/21
P05	SET-OUT HEIGHTS REVISED.	RM	26/08/21
P04	GENERAL UPDATES	RM	04/08/21
P03	ISSUE NOTE ADDED	RM	26/06/21
P02	PRINT UPDATE	SA	26/01/21
P01	FIRST ISSUE	SA	24/01/21
Rev	Description	By	Date



AJ Cladding LTD
Architectural Cladding Specialists

19A Wilson Street,
Hamilton,
ML3 0NH

+44 (0) 1698 339 104
ajcladding.co.uk
info@ajcladding.co.uk

Drawn By	SA	Date Created	04/01/21	Scale	NTS	ot A3
Contract No.	2020					
Contract Title	20: 20 HOUSE					
Drawing Title	PENTHOUSE 02 WEST ELEVATION BRACKET SETOUTS 01					
Drawing No.	2020-PH02-WES-BKT-001	Rev	C01			

PH02 APT 128
RECESSED BALCONY