

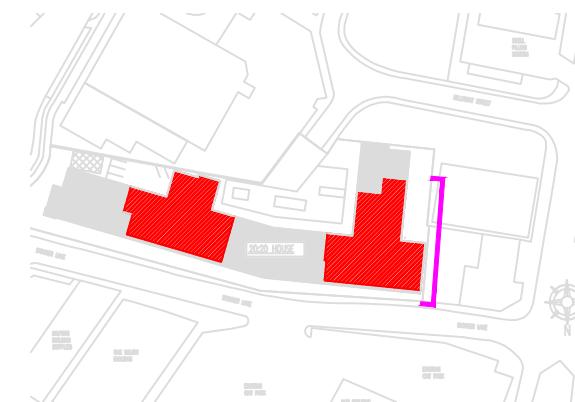
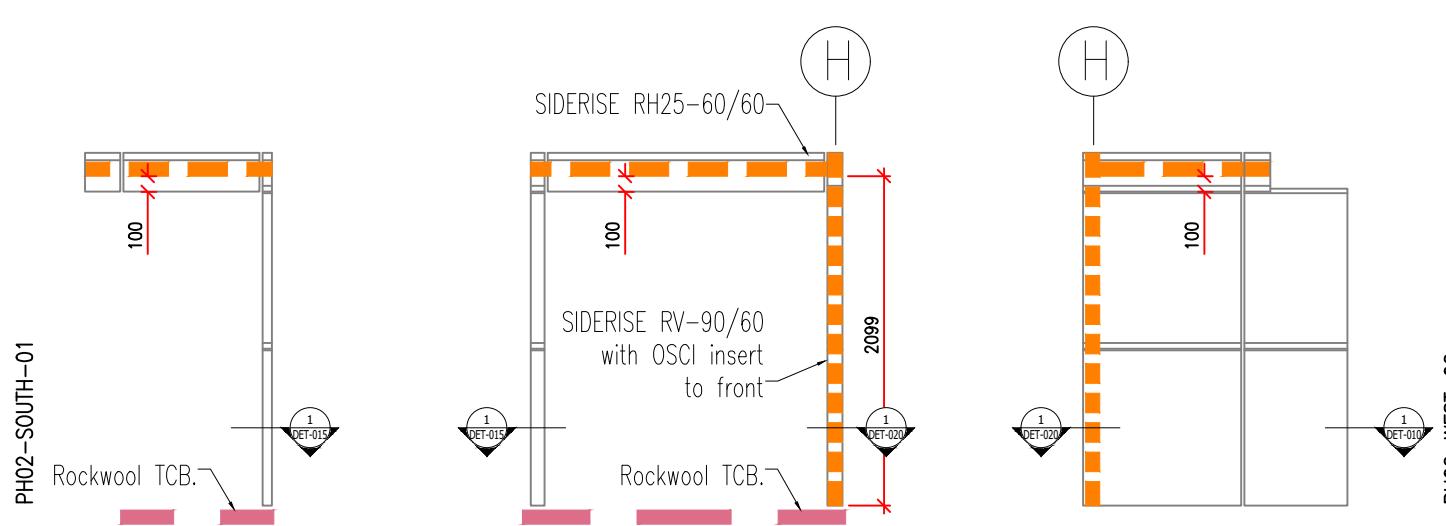


NOTE:  
IF THERE IS A GAP BETWEEN HEAD OF  
WINDOW / CURTAIN WALLING, REFER TO  
DETAIL 'DET-022'.

CAVITY BARRIERS AND FIRE STRATEGY  
SUPPLIED AND INSTALLED IN  
ACCORDANCE WITH THE REQUIREMENTS  
OF IFC SPECIFICATIONS.

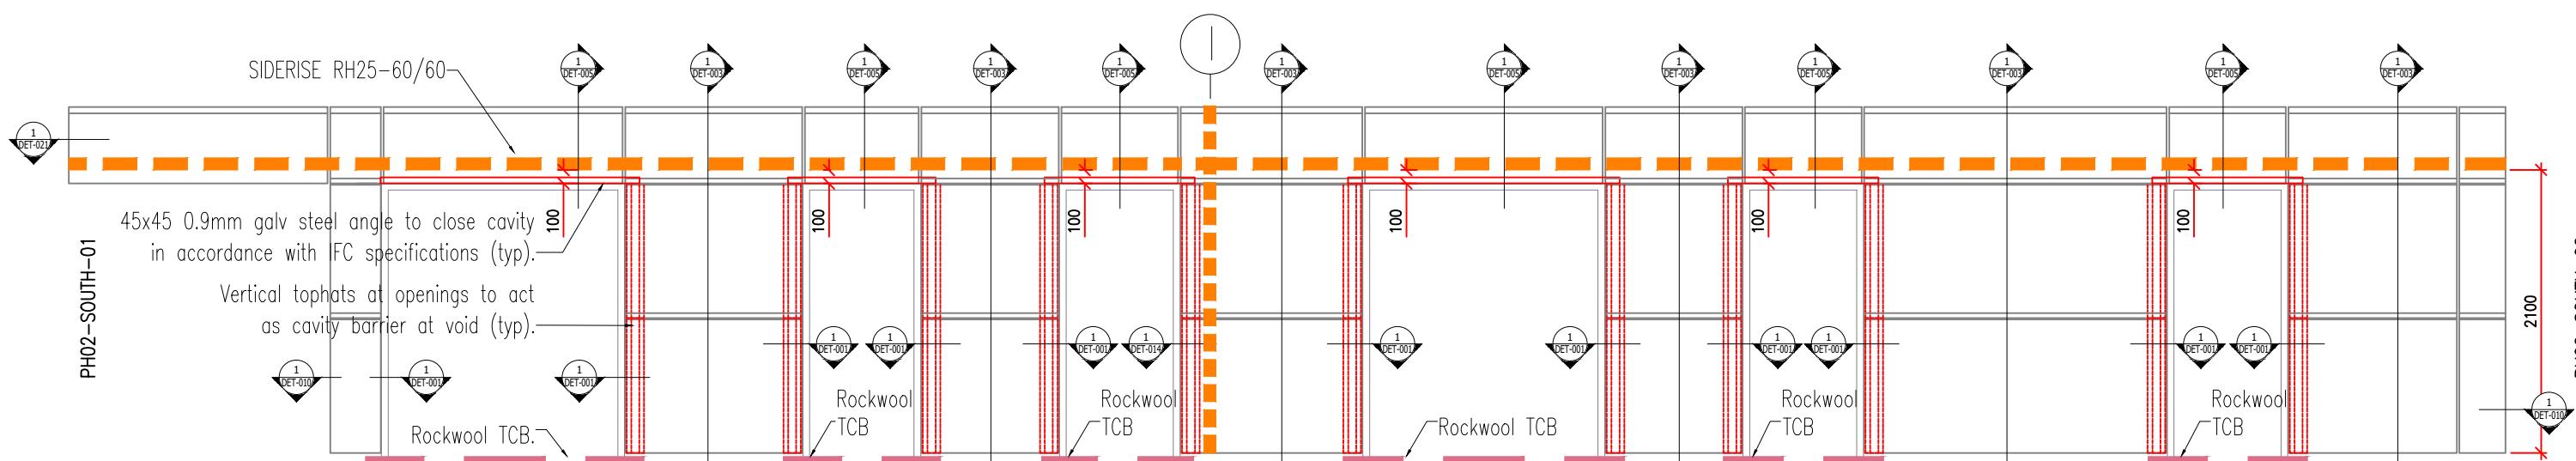

SITE KEY

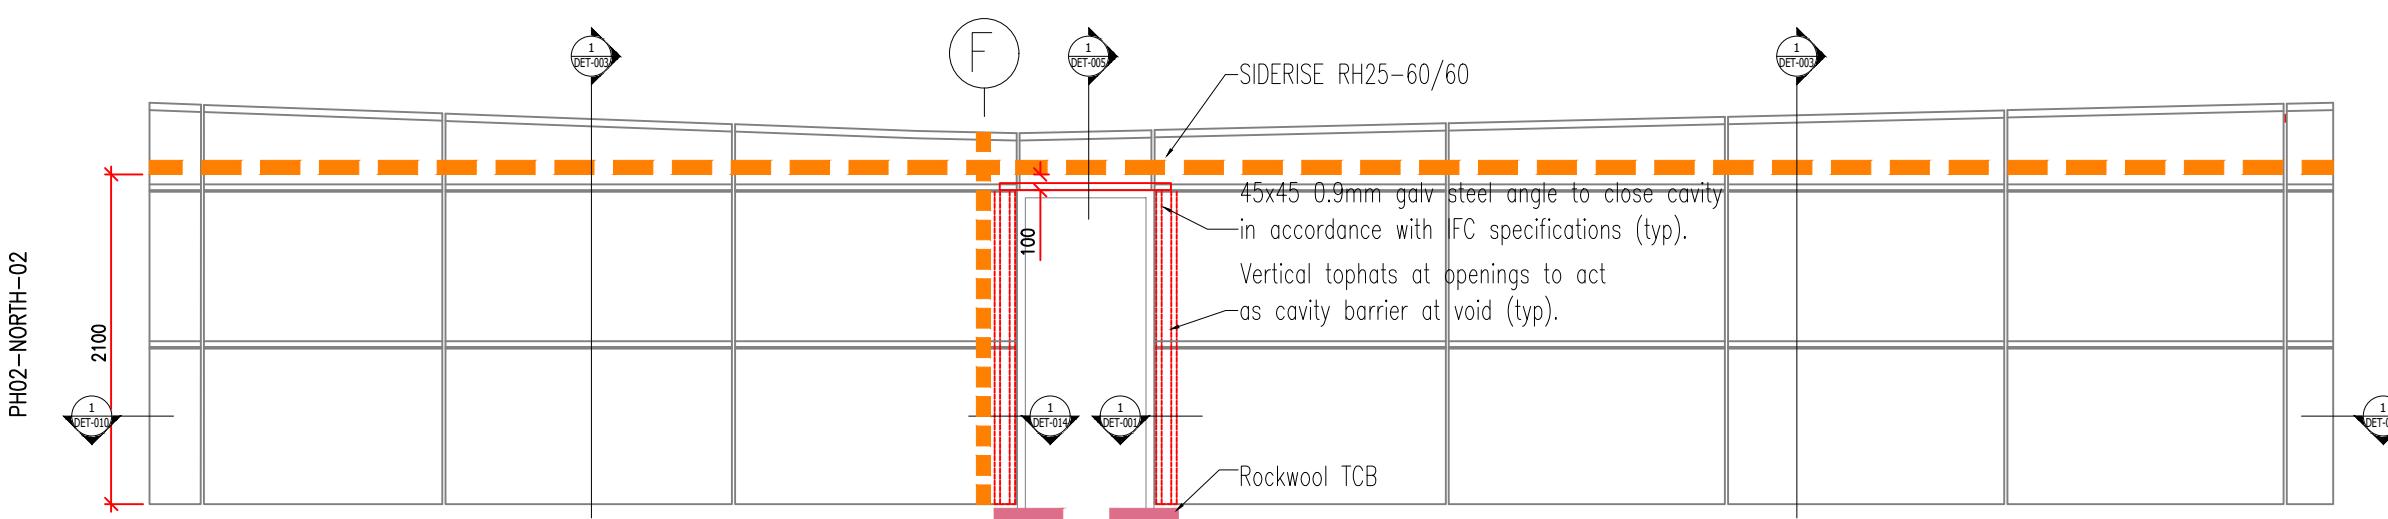

■ ■ ■ ■ ■ Denoted Siderise RH25-60/60 horizontal cavity barriers run continuously round building, typically 100mm above window openings.

■ ■ ■ ■ ■ Denoted Siderise RV-90/60 cavity barrier with OSCI inserts to cladding panel depth.

■ ■ ■ Denotes Rockwool TCB cavity barrier. To be installed from inside flats by others at every window and door. Barriers to extend 150mm past openings.

■ ■ ■ ■ ■ Denoted Siderise non vented cavity barrier round wall vent ducting.

C01	IFC NOTE ADDED - CONSTRUCTION ISSUE	RM	28/10/21
P06	UPDATED AS PER WINTECH COMMENTS 08/10/21	RM	14/10/21
P05	UPDATED AS PER WINTECH COMMENTS 30/09/21	RM	01/10/21
P04	UPDATED AS PER WINTECH COMMENTS 16/09/21	RM	23/09/21
P03	DETAIL REFS ADDED	RM	14/9/21
P02	GENERAL UPDATES.	RM	17/06/21
P01	FIRST ISSUE	RM	18/05/21
Rev	Description	By	Date

19A Wilson Street,  
Hamilton,  
ML3 0NH  
+44 (0) 1698 339 104  
ajcladding.co.uk  
info@ajcladding.co.uk



AJ Cladding LTD  
Architectural Cladding Specialists

Drawn By	RM	Date Created	18/05/21	Scale	1:50	at A3
Contract No.	2020					
Contract Title	20: 20 HOUSE					
Drawing Title	PENTHOUSE 02 WEST ELEVATION CAVITY BARRIER LAYOUT					
Drawing No.	2020-PH02-FS-004					
Rev	C01					

AS BUILT 19/11/21