



PH02 – WEST – 01

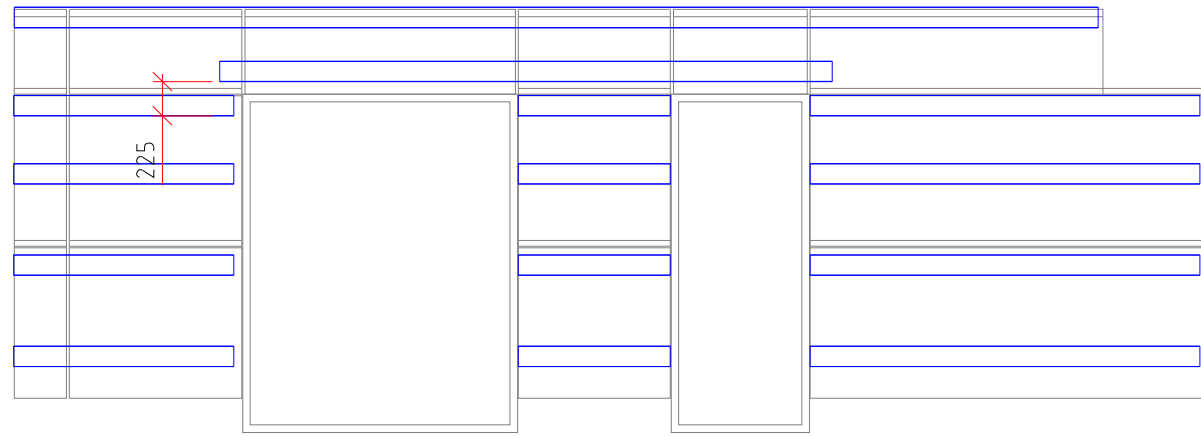

ELE – PH02–SOUTH–01


PH02 – WEST – 02

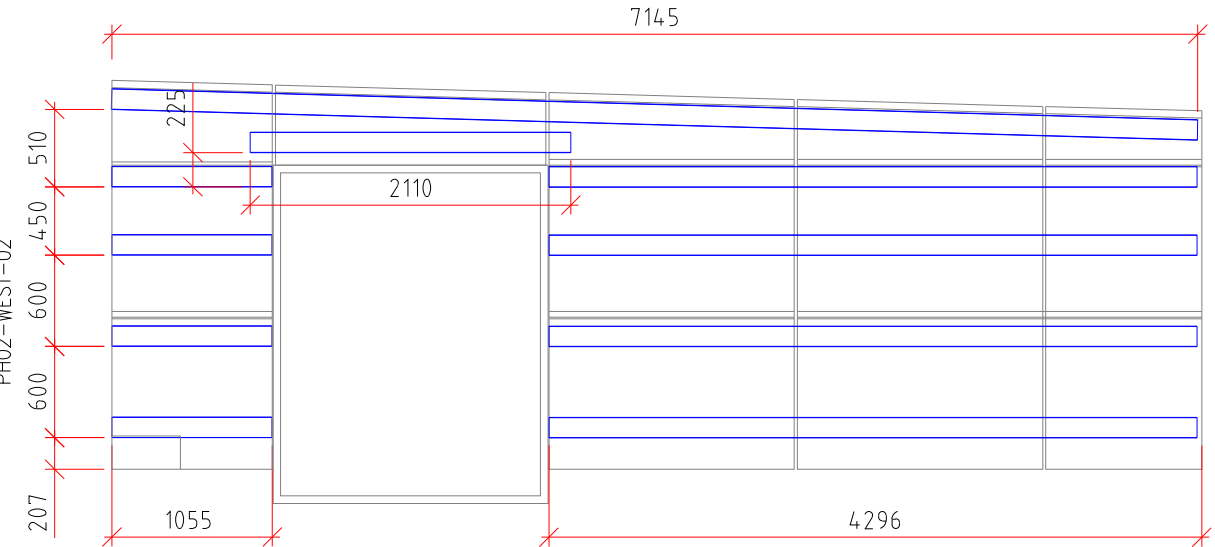

ELE – PH02–SOUTH–02


PH02 – EAST – 01

PH02 – EAST – 01

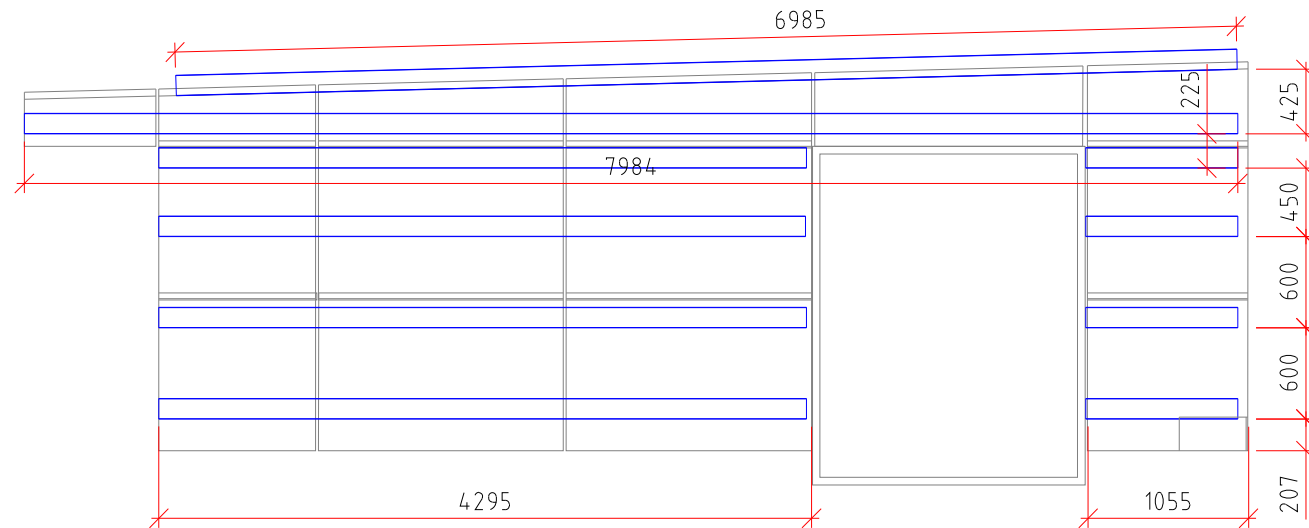

ELE – PH02–SOUTH–03

PH01 – EAST – 02

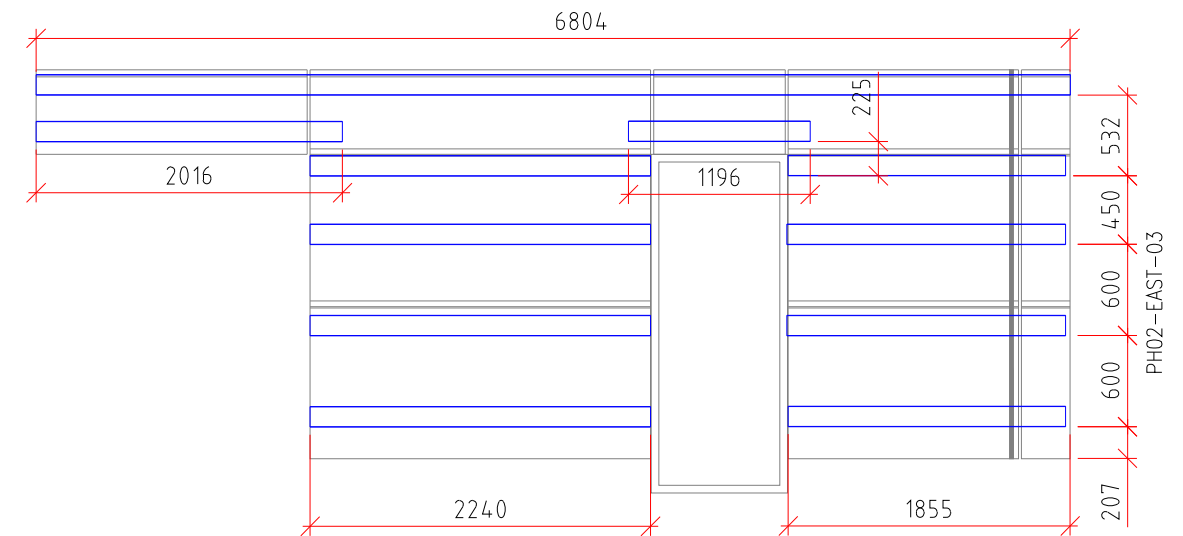




ELE – PH02–SOUTH–04

PH02 – EAST – 03

135x30 2mm GALV CHANNEL


200x30 2mm GALV CHANNEL

DESIGNED AND INSTALLED AS PER FASTFRAME DESIGN CALCULATIONS. PLEASE REFER TO FILES; –
'2020 HOUSE – PENTHOUSE NO. 2 – STEEL – VERTICAL FACADE – 90MM – GENIUS PRIME – 202041021_V1.PDF'
'2020 BUILDING – RECESS BALCONIES – STEEL – VERTICAL FACADE – 90MM – GENIUS PRIME – 202041021_V1.PDF'

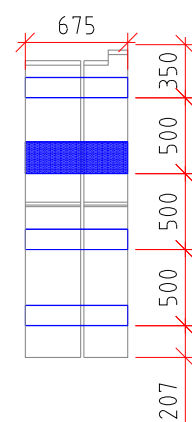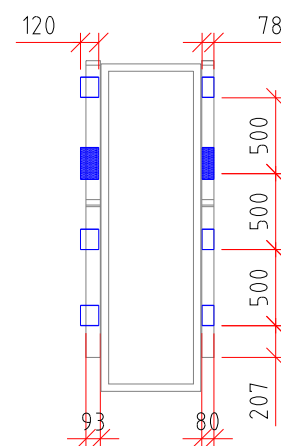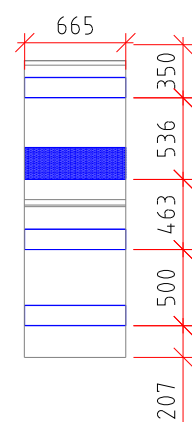

PH02 RECESSED DOOR 01

AS BUILT 19/11/21

C01	CONSTRUCTION ISSUE	RM	28/10/21
P05	UPDATED AS PER WINTech COMMENTS 08/10/21	RM	15/10/21
P04	UPDATED AS PER WINTech COMMENTS 30/09/21	RM	01/10/21
P03	UPDATED AS PER WINTech COMMENTS 16/09/21	RM	23/09/21
P02	SET-OUT HEIGHTS REVISED.	RM	26/08/21
P01	FIRST ISSUE	RM	09/07/21
Rev	Description	By	Date
<div><div>AJ Cladding LTD Architectural Cladding Specialists</div><div>19A Wilson Street, Hamilton, ML3 0NH +44 (0) 1698 339 104 ajcladding.co.uk info@ajcladding.co.uk</div></div>			
Drawn By	RM	Date Created	09/07/21
Contract No.	2020	Scale	1:50
Contract Title	20: 20 HOUSE	ot	A3
Drawing Title	PENTHOUSE 02 SOUTH ELEVATION GALV CHANNEL SETOUT 03		
Drawing No.	2020-PH02-CH-003	Rev	C01